

Russell KANSAS
 Map No. 73 Sec. 32 Twp. 15 R. 13^W
 Well No. 6-Michaelis
Gulf Company
 Contractor

FIRST REPORT

940 Ft. from N. Line
 _____ Ft. from S. Line
 _____ Ft. from E. Line
940 Ft. from W. Line

SECTION PLAT

	0		

Location _____

Rig up _____

Drilling and Remarks:

B.R.R.

RECORD

Cased _____ in., _____ ft.

Sand _____

Gas _____

Oil _____

Total Depth _____

PRODUCTION

1st 24 hrs. Nat. _____

1st 24 hrs. after shot _____

Gas _____ Cu. Ft.

Dry Hole _____

Abandoned _____

Date

MAY 19 1937

19

H. D. Hatfield

Scout

Russell KANSAS
 Map No. _____ Sec. 32 Twp. 15 R. 13^W
 Well No. 6-Michaelis
Gulf Company
 Contractor

COMPLETED

940 Ft. from N. Line
 _____ Ft. from S. Line
 _____ Ft. from E. Line
940 Ft. from W. Line

SECTION PLAT

	0		

Location _____

Rig up _____

Drilling and Remarks:

2000 AcidPump 894/12Rot - 1798

RECORD

Cased 6 in., 3338 ft.Sand 511 3338

Gas _____

Oil _____

Total Depth 3354

PRODUCTION

1st 24 hrs. Nat. _____

1st 24 hrs. after shot _____

Gas _____ Cu. Ft.

Dry Hole _____

Abandoned _____

Date

JUN 30 1937

19

H. D. Hatfield

Scout

Russell

Sec. 32 Twp. 15 R. 13-W

Well No. #6 Michaelis Farm

Gulf Company


990 Ft. from N. Line

Ft. from S. Line

Ft. from E. Line

980 Ft. from W. Line

Elev. 1902

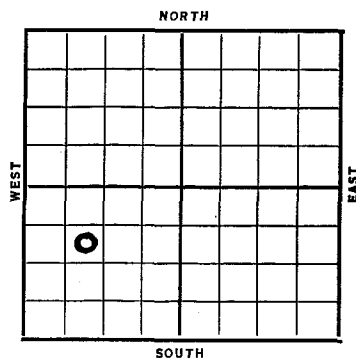

Date	REPORT
1937	
5/19	B.R.R.
5/28	S. H.
6/4	10" @ 611'. Drlg. 1650'.
6/11	Drlg. 2404'.
6/19	Drlg. 3025'.
6/25	Sil. & 6" @ 3338'.
	T.D. 3349'. 700' oil.
/30	6" @ 3338'.
	Sil. 3338'.
	T.D. 3354'.
	2000 acid.
	Pump 894 bbls. 12 hrs.
	Potential 1798 bbls.
	COMPLETED

Form 51-5M-12-36 Com'l

Russell KANSAS

Section.....32.....Township.....15.....Range.....13-W.....

Well Number 6 - Michaelis

Company.....Gulf.....

