

Map No. _____ Sec. 32 Twp. 15 R. 13^WWell No. 5-MichaelisGulf Company

Contractor

FIRST REPORT**SECTION PLAT**

	0		

330 Ft. from N. Line

_____ Ft. from S. Line

990 Ft. from E. Line

_____ Ft. from W. Line

Location ✓

Rig up _____

Drilling and Remarks:

RECORD

Cased _____ in., _____ ft.

Sand _____

Gas _____

Oil _____

Total Depth _____

PRODUCTION

1st 24 hrs. Nat. _____

1st 24 hrs. after shot _____

Gas _____ Cu. Ft.

Dry Hole _____

Abandoned _____

Date

APR 28 1937

19

H. D. Hatfield ScoutMap No. 73 Sec. 32 Twp. 15 R. 13^WWell No. 5-MichaelisGulf Company

Contractor

COMPLETED**SECTION PLAT**

	0		

330 Ft. from N. Line

_____ Ft. from S. Line

990 Ft. from E. Line

_____ Ft. from W. Line

Location _____

Rig up _____

Drilling and Remarks:

4000 AcidPump 764/12Pot - 1528**RECORD**Cased 6 in., 3319 ft.Sand 511 3319

Gas _____

Oil _____

Total Depth 3331**PRODUCTION**

1st 24 hrs. Nat. _____

1st 24 hrs. after shot _____

Gas _____ Cu. Ft.

Dry Hole _____

Abandoned _____

Date


JUN 16 1937

19

H. D. Hatfield Scout

Sec. 32 Twp. 15 R. 13-WWell No. #5 Michaelis FarmGulf Company330 Ft. from N. Line Ft. from S. Line990 Ft. from E. Line Ft. from W. Line

Elev. 1878

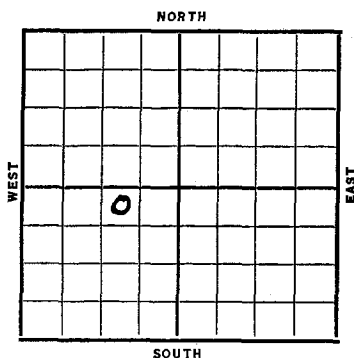

Date	REPORT
1937	
4/28	Location
5/7	Rot rig.
5/14	Drlg. 626'.
5/21	10" @ 628'. Drlg. 2180'.
5/28	Drlg. 2950'.
6/4	Sil. 3319±22' T.D.
	6" @ 3319'. Drlg. cement.
6/11	T.D. 3331'. Swab 187 oil
	6 hrs. 4000 acid.
6/16	6" @ 3319'.
	Sil. 3319'.
	T.D. 3331'.
	4000 Acid
	Pump 764 bbls. 12 hrs.
	Pot. 1528 bbls.
	COMPLETED

Section 32 Township 15 Range 13-WWell Number 5 - MichaelisCompany Gulf