

Russell

Map No. 73 Sec. 32 Twp. 15 R. 13WWell No. 5 NeidensW. I. Southern

Company

Contractor

FIRST REPORT

SE NE NE

990 Ft. from N. Line

Ft. from S. Line

330 Ft. from E. Line

Ft. from W. Line

SECTION PLAT

			0

Location

RECORD

Cased 7 in., 3337 ft.

Sand

Gas

Oil

Total Depth

PRODUCTION

1st 24 hrs. Nat.

1st 24 hrs. after shot

Gas Cu. Ft.

Dry Hole

Abandoned

10" - 286

WOC

Date

JUN 15 1938 19 H. D. Hatfield Scout

Russell

Map No. 73 Sec. 32 Twp. 15 R. 13WWell No. 5 NeidensW. I. Southern

Company

Contractor

COMPLETED

SE NE NE

990 Ft. from N. Line

Ft. from S. Line

330 Ft. from E. Line

Ft. from W. Line

SECTION PLAT

			0

Location

RECORD

Cased 7 in., 3337 ft.Sand Arb 3337

Gas

Oil

Total Depth 3340

PRODUCTION

1st 24 hrs. Nat.

1st 24 hrs. after shot

Gas Cu. Ft.

Dry Hole

Abandoned

500 acid

POT 1378

Date

JUL 20 1938 19 H. D. Hatfield Scout

KANSAS

Russell


Sec. 32 Twp. 15 R. 13-WWell No. #5 Neidens FarmW. I. Southern Company990 Ft. from N. Line

Ft. from S. Line

330 Ft. from E. Line

Ft. from W. Line

Elev. 1893'

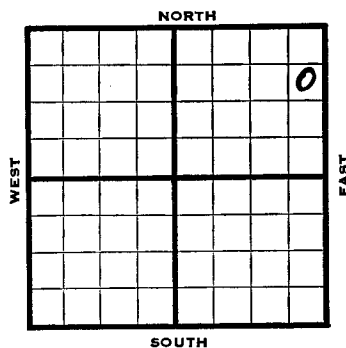

REPORT

1938

6/15 10" @ 286'. WOC.

6/24 Drlg. 2107'.

7/1 Drlg. 3060'.

7/8 K. C. 3090'. Sat. Line 3101-20'

Arb. 3337'. 7" - 3337'.

RUST.

7/15 T.D. 3340'. 650' oil 5 hrs.

500 acid. Pump 196 oil in 3 hrs.

7/20 7" - 3337'.

Arb. 3337'.

T. D. 3340'.

500 acid.

Potential 1378 bbls.

COMPLETED

Russell

KANSAS

Section 32 Township 15 Range 13-WWell No. 5 NeidensCompany W. I. Southern