

Map No. 73 Sec. 32 Twp. 15 R. 13W

Well No. 6 Boomhower

Southern Oil Company

Contractor

SECTION PLAT

	0		

_____ Ft. from N. Line

990 Ft. from S. Line

990 Ft. from E. Line

_____ Ft. from W. Line

FIRST REPORT

Location _____

Rig up _____

Drilling and Remarks:

Rig

RECORD

Cased _____ in., _____ ft.

Sand _____

Gas _____

Oil _____

Total Depth _____

PRODUCTION

1st 24 hrs. Nat. _____

1st 24 hrs. after shot _____

Gas _____ Cu. Ft.

Dry Hole _____

Abandoned _____

Date

FEB 3 1937 19

S. J. LEWIS Scout

Map No. _____ Sec. 32 Twp. 15 R. 13W

Well No. 6 Boomhower

Southern Company

Contractor

SECTION PLAT

	0		

_____ Ft. from N. Line

990 Ft. from S. Line

990 Ft. from E. Line

_____ Ft. from W. Line

COMPLETED

Location _____

Rig up _____

Drilling and Remarks:

Sit 8299
4000 cu. ft.
Potential
960

RECORD

Cased _____ in., _____ ft.

Sand _____

Gas _____

Oil _____

Total Depth 3302

PRODUCTION

1st 24 hrs. Nat. _____

1st 24 hrs. after shot _____

Gas _____ Cu. Ft.

Dry Hole _____

Abandoned _____

Date

APR 7 1937 19

S. J. LEWIS Scout

Form 22-1 IM-106-1-1 place **O. W. P. B. KANSAS Russell** ✓

Sec. 32 Twp. 15 R. 13-W

Well No. 16 Boomhower Farm

Cactus Oil Company
Southern Oil

NWSE NW


_____ Ft. from N. Line

990 Ft. from S. Line

990 Ft. from E. Line

_____ Ft. from W. Line

Elev. 1867

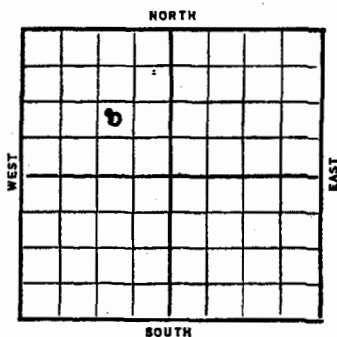

Date	REPORT
1937	
2/3	Rig.
2/11	Rig
2/19	"
2/26	"
3/4	10" @ 360'. Drlg. 1040'.
3/11	Drlg. 2795'.
3/18	Oswald 3050'
	7" @ 3053 RUST
3/25	Drlg. 3213'.
4/2	Sil 3299' T.D. 3303'-4000 acid.
4/7	Sil. 3299'.
	T. D. 3303'.
	4000 acid.
	Potential 960.
	COMPLETED
	OVER

1954
3/17

O. W. P. B.

Oil well TD 3303 KC 3050-3156
Arb. 3299 5" @ 3299 OTD 3303
SP 3095 60/3062-82 B/3 GOPH 8 hr.
3000 A P/46 BO CO to 3095
B/1 1/2 BFPH 40% oil 500 A
Comp. 9 BOPD 8 BW

FIRST REPORT

COMPLETED

O. W. P. B.

County Russell State Kansas
 Sec. 32 (Blk.) 15 (Sur.) 15W Map No.
 Operator Carter Oil
 Well No. 8 Farm Boomhower
 Elev. 1867 Location NW SE NW

FIRST REPORT	
0	✓
COMPLETE	

990 Ft. From 8 Line NW
 990 Ft. From 8 Line Quarter
 Ist. Report MAR 7 1954
 Completion MAR 7 1954
 Remarks OWPB
 O. W. P. B.
 Spudding Date

Drig. Data Oil well TD 3303
KC 3050-3156 Arb. 3299 5" @ 3299
OTD 3303 SP 3095 60/ 3062-88
B/ 8 geph 8 hr. 3000 A P/ 46 bo
OO to 3095 B/ 1 1/2 bfph 40% oil 500 A
Comp. 9 bepd 8 bw

J. G. McGLADE

O. W. P. B.

Russell

KANSAS

Section 32 Township 15 Range 13-WWell Number 6 BoomhowerCompany Carter Oil
Southern Oil