

Form 28-1M Bks.-2-29 KANSAS

Map No. 73 Sec. 32 Twp. 15 R. 13W

Well No. 4 Boomhower

Southern Company

Contractor

SECTION PLAT

		0	

Ft. from N. Line

330 Ft. from S. Line

330 Ft. from E. Line

Ft. from W. Line

FIRST REPORT

Location ☒

RECORD

Cased _____ in., _____ ft.

Sand _____

Gas _____

Oil _____

Total Depth _____

PRODUCTION

1st 24 hrs. Nat. _____

1st 24 hrs. after shot _____

Gas _____ Cu. Ft.

Dry Hole _____

Abandoned _____

Date

JAN 27 1937

19

S. J. LEWIS

Scout

Form 28-1M Bks.-2-29 KANSAS Russell

Map No. 73 Sec. 32 Twp. 15 R. 13W

Well No. 4 Boomhower

Southern Company

Contractor

SECTION PLAT

		0	

Ft. from N. Line

330 Ft. from S. Line

330 Ft. from E. Line

Ft. from W. Line

COMPLETED

Location

RECORD

Cased _____ in., _____ ft.

Sand _____

Gas _____

Oil _____

Total Depth 3314

PRODUCTION

1st 24 hrs. Nat. _____

1st 24 hrs. after shot _____

Gas _____ Cu. Ft.

Dry Hole _____

Abandoned _____

Date

MAR 24 1937

19

S. J. LEWIS

Scout

KANSAS

RUSSELL

Sec. 32 Twp. 15 R. 13W

Well No. 4 Boomhower Farm
Southern Company


Ft. from N. Line

330 Ft. from S. Line

330 Ft. from E. Line

Ft. from W. Line

Elev. 1859

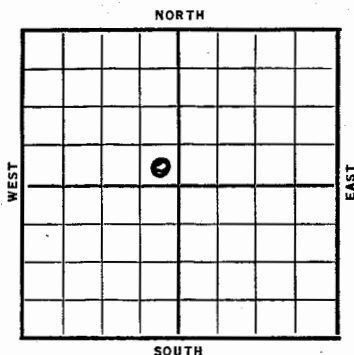

Date 1937 REPORT

1/27 Lodation

2/4 Surface hole

2/11 10" @ 361 Drlg. 1155'.

2/19 Drlg. 2585'.

2/26 Sil. 3216. Set 5" liner WOC

3/4 Never had Sil. Oswald 3043'.

7" @ 3045'. RUST.

3/11 Sil 3301. Drlg.

3/18 TD 3314', 4000 acid. No test.

3/24 Sil. 3301'.

T. D. 3314'.

4000 acid.

Potential 1307.

COMPLETED

KANSAS

Russell

Section 32 Township 15 Range 13-W

Well Number 4 Boomhower

Company Southern

