

Map No. 73 Sec. 33 Twp. 15 R. 13W

Well No. 5 Sellens

Shell Company

FIRST REPORT Contractor

SECTION PLAT

SW NE SW

995 Ft. from N. Line

Ft. from S. Line

989 Ft. from E. Line

Ft. from W. Line

TRAPP POOL

Location <u>X</u>	RECORD
Rig up _____	Cased _____ in., _____ ft.
Drilling and Remarks:	Sand _____
	Gas _____
	Oil _____
	Total Depth _____
	PRODUCTION
	1st 24 hrs. Nat. _____
	1st 24 hrs. after shot _____
	Gas _____ Cu. Ft.
	Dry Hole _____
	Abandoned _____

Date FEB 12 1941 19 S. J. LEWIS Scout

Map No. 73 Sec. 33 Twp. 15 R. 13W

Well No. 5 Sellens

Shell Company

Contractor

COMPLETED

SECTION PLAT

SW NE SW

995 Ft. from N. Line

Ft. from S. Line

989 Ft. from E. Line

Ft. from W. Line

TRAPP POOL

Location _____	RECORD
Rig up _____	Cased _____ in., _____ ft.
Drilling and Remarks:	Sand _____
	Gas _____
	Oil _____
	Total Depth <u>3248</u>
	PRODUCTION
	1st 24 hrs. Nat. _____
	1st 24 hrs. after shot _____
	Gas _____ Cu. Ft.
	Dry Hole _____
	Abandoned _____

Date MAR 2 6 1941 19 S. J. LEWIS Scout

Ar 8342.
4" C3343
8000 cuic
Sept 18 19342
Mar 2000
392

Sec. 33 Twp. 15 R. 13-W

Well No. #5 Sellens Farm _____
Shell Company _____

(Trapp)


995 Ft. from N. Line

_____ Ft. from S. Line

989 Ft. from E. Line

_____ Ft. from W. Line

Elev. 1903

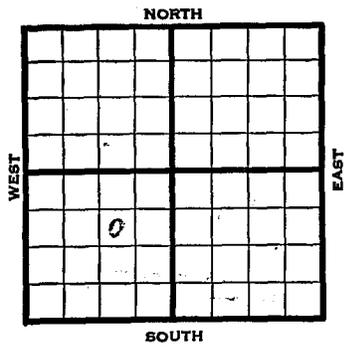

1941		REPORT
2/12	Location	
2/20	Rotary.	
2/27	8" - 360' Drl g. 2307'	
3/6	Topeka 2775' Lens. 3097'	
	Arb. 3342-44' T.D. 4" - 3343'	
	RUST.	
3/13	T.D. 3348' 3000 acid.	
	Swab 518 oil in 9 hours.	
3/20	" " " "	
3/26	Arb. 3342'	
	4" - 3343'	
	T.D. 3348'	
	3000 acid.	
	Depthograph potential 9342 bbls.	
	Maximum 3000 bbls.	
	39. Gravity	
		COMPLETED

Form 51-5M-7-40-Palace

Section 33 Township 15 Range 13-W

Well No. #5 Sellens

Company Shell

