

Russell

KANSAS

Map No. _____ Sec. 33 Twp. 15 R. 13WWell No. 1 B. SellensShell

Company

Contractor

FIRST REPORT

SW/C

_____ Ft. from N. Line

330 Ft. from S. Line

_____ Ft. from E. Line

330 Ft. from W. Line

TRAPP POOL

SECTION PLAT

Location _____

Rig up _____

Drilling and Remarks:

Rotary

RECORD

Cased _____ in., _____ ft.

Sand _____

Gas _____

Oil _____

Total Depth _____

PRODUCTION

1st 24 hrs. Nat. _____

1st 24 hrs. after shot _____

Gas _____ Cu. Ft.

Dry Hole _____

Abandoned _____

Date

OCT 19

19

S. J. LEWIS

Scout

Russell

KANSAS

Map No. 73 Sec. 33 Twp. 15 R. 13WWell No. 1 B. SellensShell

Company

Contractor

COR 12111

SW/C

_____ Ft. from N. Line

330 Ft. from S. Line

_____ Ft. from E. Line

330 Ft. from W. Line

TRAPP POOL

SECTION PLAT

Location _____

Rig up _____

Drilling and Remarks:

*Cor & 3321**4" C 3322**2000 feet**Depth graph P & S**1689*

RECORD

Cased _____ in., _____ ft.

Sand _____

Gas _____

Oil _____

Total Depth *3330*

PRODUCTION

1st 24 hrs. Nat. _____

1st 24 hrs. after shot _____

Gas _____ Cu. Ft.

Dry Hole _____

Abandoned _____

Date

NOV 28 1939

19

S. J. LEWIS

Scout

Sec. 33 Twp. 15 R. 13-W

Well No. #1 B. Sellens Farm

Shell Company

(Trapp)


 Ft. from N. Line

330 Ft. from S. Line

 Ft. from E. Line

330 Ft. from W. Line

Elev. 1885

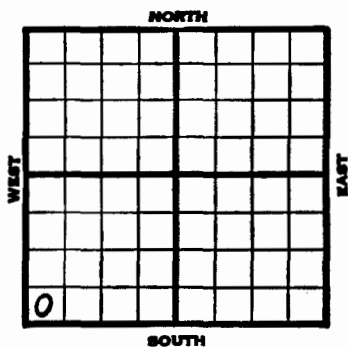

1939	REPORT
10/25	Rotary.
11/2	8" - 665' Anhy 865'
	Ft. Riley 1790' Drlg. 2350'
11/9	Neva 2140' Toheka 2765'
	Lans. 3079' Arb. 3321'
	4" - 3322' TD 3323' RUST.
11/16	Drlg. 3328' 2050' oil.
11/23	T.D. 3330' 2000 acid.
	Swab 180 bbls. oil 5 hours.
11/28	Arb. 3321'
	4" - 3322'
	2000 acid.
	T.D. 3330'
	Depthograph potential 1639 bbls.
	COMPLETED

Section 33 Township 15 Range 13-W

Well No. #1 B. Sellens

Company Shell

