

Map No. 73 Sec. 33 Twp. 15 R. 13WWell No. 5 Hinderliter

Leader Oil

Company

Contractor

FIRST REPORT

SECTION PLAT

SE NW

Ft. from N. Line

330 Ft. from S. Line330 Ft. from E. Line

Ft. from W. Line

CORALENA POOL

Location

RECORD

Cased in., ft.

Sand

Gas

Oil

Total Depth

PRODUCTION

1st 24 hrs. Nat.

1st 24 hrs. after shot

Gas Cu. Ft.

Dry Hole

Abandoned

Date

MAY 27 1941 19 S. J. LEWIS Scout

Map No. Sec. 33 Twp. 15 R. 13WWell No. 5 Hinderliter

Leader Oil

Company

Contractor

COMPLETE

SECTION PLAT

SE NW

Ft. from N. Line

330 Ft. from S. Line330 Ft. from E. Line

Ft. from W. Line

CORALENA POOL

Location

RECORD

Cased in., ft.

Sand

Gas

Oil

Total Depth 3245

PRODUCTION

1st 24 hrs. Nat.

1st 24 hrs. after shot

Gas Cu. Ft.

Dry Hole

Abandoned

Date

JUN 25 1941 19 S. J. LEWIS Scout

Sec. 33 Twp. 15 R. 13-WWell No. #5 Hinderliter FarmLeader Oil Company


(Coralena)

Ft. from N. Line

330 Ft. from S. Line330 Ft. from E. Line

Ft. from W. Line

Elev. 1894

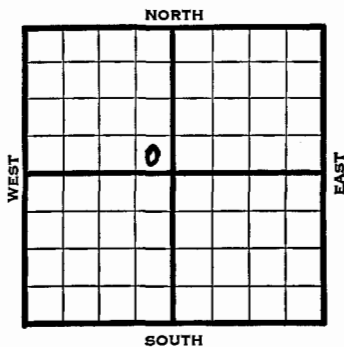

1941	REPORT
5/27	Rotary .
6/5	"
6/12	Lens. 3092' Drlg. 3330'
6/19	Arb. 3340' 5" - 3341'
	T.D. 3345' 1600' oil 2 hours.
	2000 acid. Echometer test 1545
	bbls. 2000 acid. Testing.
6/25	Arb. 3340'
	5" - 3341'
	T.D. 3345'
	6000 acid.
	Echometer potential 2864 bbls.
	88.2 Gravity
	COMPLETED

Russell

Section 33 Township 15 Range 13-WWell No. #5 HinderliterCompany Leader Oil

Coralena pool

