

KANSAS

Map No. 73 Sec. 33 Twp. 15 R. 13WWell No. 1-BerrySignal Oil Company

Contractor

1931 REPORTS

SECTION PLAT

Ft. from N. Line

330 Ft. from S. Line330 Ft. from E. Line

Ft. from W. Line

Location

Rig up

Drilling and Remarks:

cellar

RECORD

Cased.....in., ...ft.

Sand.....

Gas.....

Oil.....

Total Depth.....

PRODUCTION

1st 24 hrs. Nat.....

1st 24 hrs. after shot.....

Gas.....Cu. Ft.

Dry Hole.....

Abandoned.....

Date

ORVAL MANNSCHRECK

192

Scout

KANSAS

Map No. 73 Sec. 33 Twp. 15 R. 13WWell No. 1-BerrySignal Oil Company

Contractor

SECTION PLAT

Ft. from N. Line

330 Ft. from S. Line330 Ft. from E. Line

Ft. from W. Line

COMPLETED

Location

Rig up

Drilling and Remarks:

291 oil

RECORD

Cased.....in., ...ft.

Sand Sil 3332

Gas.....

Oil.....

Total Depth 3336

PRODUCTION

1st 24 hrs. Nat.....

1st 24 hrs. after shot.....

Gas.....Cu. Ft.

Dry Hole.....

Abandoned.....

Date

JAN 8 1936


192

ORVAL MANNSCHRECK

Scout

Russell
KANSAS
Map No. *33* Sec. *15* Twp. *13W*
Well No. *1- Berry* Farm
Signal Oil Company


Ft. from N. Line
330
Ft. from S. Line
330
Ft. from E. Line
Ft. from W. Line
Elev. 1883

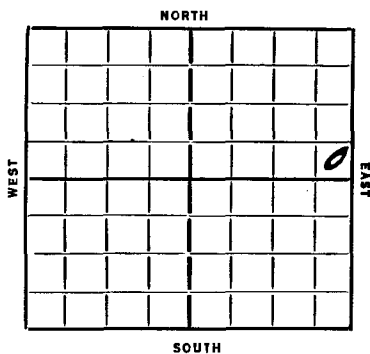

REPORT

10/2 Cellar
10/9 Ponds
11/1 Cellar
11/7 Aly 285
11/14 d 660 15" 420
11/21 " 1202
11/29 12" 840 Top Auging 840
12/6 Aly 1995
12/6 " 2595 10" 2164
12/13 Top Lansing 3075
8" 3076 WO C
12/19 40" 3295-3300 6" 3333
40" 3333-35 1/2 TD
12/26 TD 3336 3000' OEH
SD for tanks
12/36 Pot 391 SPO.
1/7 Top 5 ft. cap up 3363
1/8 3333
TD 3336
391 Oil COMPLETED

Russell
KANSAS
Map No. *33* Sec. *15* Twp. *13W*
Well No. *1- Berry* Farm
Signal Oil Company

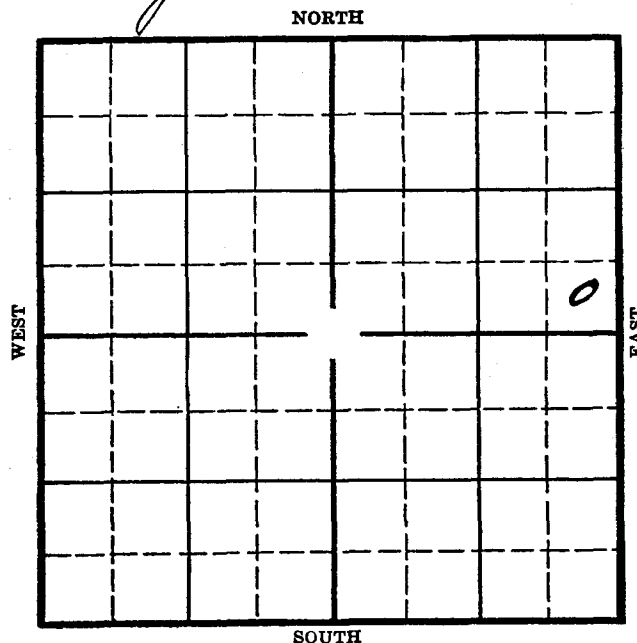

Location
Drilling Remarks

Rig Up
Drilling Remarks

RECORD

Cased _____ in. _____ ft.
Sand _____
Gas _____
Oil _____
Total Depth _____

PRODUCTION

1st 24 hrs. Nat. _____
1st 24 hrs. after shot _____
Gas _____ cu. ft.
Dry Hole _____
Abandoned _____