

Kansas

Trapp Pool

Map No. _____ Sec. 33 Twp. 15 R. 13W


Well No. 1 Michaelis

Keystone Pet. _____ Company

Murfine Drlg. _____ Contractor

SW SW SE

SECTION PLAT

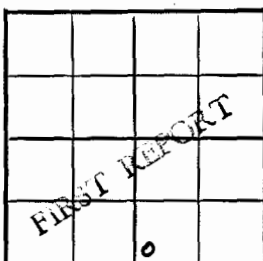

Ft. from N. Line

330 Ft. from S. Line

Ft. from E. Line

330 Ft. from W. Line

Russell County

Shell farmout

Location _____

Rig up _____

Drilling and Remarks:

Spud 3-27-50

8 5/8" @ 153

RECORD

Cased _____ in., _____ ft.

Sand _____

Gas _____

Oil _____

Total Depth _____

PRODUCTION

1st 24 hrs. Nat. _____

1st 24 hrs. after shot _____

Gas _____ Cu. Ft.

Dry Hole _____

Abandoned _____

Date

MAR 29 1950

19

J. E. TYRA

Scout

Kansas

Trapp Pool

Map No. _____ Sec. 33 Twp. 15 R. 13W

Well No. 1 Michaelis


Keystone Pet. _____ Company

_____ Contractor

SW SW SE

E1. 1900

SECTION PLAT

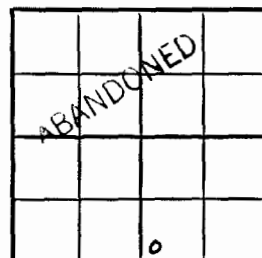

Ft. from N. Line

330 Ft. from S. Line

Ft. from E. Line

330 Ft. from W. Line

Russell County

Location _____

Rig up _____

Drilling and Remarks:

8 5/8" @ 153

ark. 3350

5" @ 3351

TD. 3365

PB 3355

D+A

RECORD

Cased _____ in., _____ ft.

Sand _____

Gas _____

Oil _____

Total Depth 3365

PRODUCTION

1st 24 hrs. Nat. _____

1st 24 hrs. after shot _____

Gas _____ Cu. Ft.

Dry Hole _____

Abandoned _____

Date

APR 26 1950

19

J. E. TYRA

Scout

Russell KANSAS

Sec. 33 Twp. 15 R. 13W

Well No. #1 Michaelis Farm

Keystone Pet. Company

Murfin Drlg. Contractor

Trapp Pool


Ft. from N. Line

330' Ft. from S. Line

Ft. from E. Line

330' Ft. from W. Line

SW SW SE

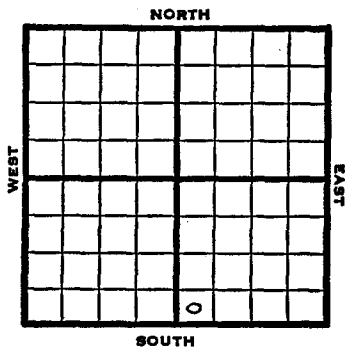

1950 Elev 1900' REPORT

3/29 Spud 3-27-50
8-5/8" @ 153'

4/26 TD 3365'
8 5/8" @ 153'
Arb. 3350'
5" @ 3351'
TD 3365
PB 3355'
D&A
Aband.

ABANDONED

Russell

KANSAS

Section 33 Township 15 Range 13W

Well No. #1 Michaelis

Company Keystone Pet.

