

Russell County Kansas State

Map No. Sec. 33 Twp. 15 R. 13W

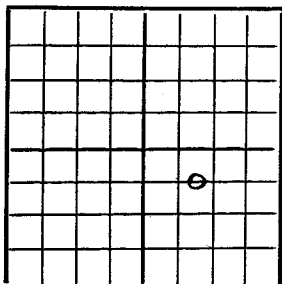
Well No. 1 - "B" McMichaelis

Shawver - Graham et al. Company

FIRST REPORT Contractor

C E L NW SE

SECTION PLAT

660 N
Ft. from N. Line

Ft. from S. Line

Ft. from E. Line

990 Ft. from W. Line

Trapp Pool

Remarks:

8 5/8" @ 290 Anny 860 drlg. 2240

Date
SEP 1 1948

Scout

S. J. LEWIS

Form 26—200 Bks.—1-48—Palace
Kansas

Trapp Pool

Map No. 13 Sec. 33 Twp. 15 R. 13W

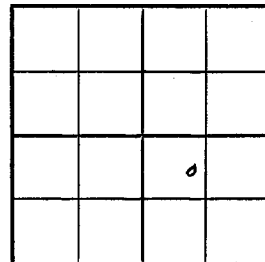
Well No. 1 "B" McMichaelis

Shawver - Graham et al. Company

COMPLETE Contractor

C E L NW SE

SECTION PLAT

660 N
Ft. from N. Line

660 Ft. from S. Line

Ft. from E. Line

990 Ft. from W. Line

Russell County

Location

Rig up

Drilling and Remarks:

Cer X3349

5" C3349

Pump 25 in. Port

40 2/3

RECORD

Cased in., ft.

Sand

Gas

Oil ✓

Total Depth 3255

PRODUCTION

1st 24 hrs. Nat.

1st 24 hrs. after shot

Gas Cu. Ft.

Dry Hole

Abandoned

Date

SEP 29 1948 19 S. J. LEWIS Scout

KANSAS Russell

Sec. 33 Twp. 15 R. 13W

Well No. 1 - "B" McMichaelis Farm

Shawver - Graham et al Company

Trapp Pool

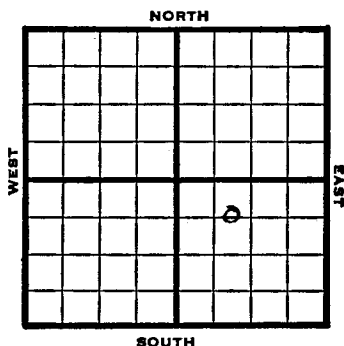
 Ft. from N. Line

660 Ft. from S. Line

 Ft. from E. Line

990 Ft. from W. Line

C E L N W S E



1948 Elev. 1897' REPORT

9/1 8 5/8" @ 290'

Anhy 860'

Drlg. 2240'

9/8 Lansing 3097'

Arb. 3349'

TD 3350'

5" @ 3349'

9/14 TD 3355

Swb 25 bbls oil a day

9/21 "

9/29 Arbuckle 3349'

5" @ 3349'

Pump 25 oil Pot.

Gr. 40°

TD 3355'

COMPLETED

KANSAS

Russell

Section 33 Township 15 Range 13W

Well No. 1-"B" McMichaelis

Trapp Pool

Company Shawver-Graham et al

