

FORM 513 REV. SUNRAY

County Russell Elev. 1883
 Sec. 34 Twp. 18 Rge. 13W
 Company Michaelis Operations
 Farm Name Berry No. 3

TOPS	DEPTH	LOG	DATUM	Loc. in Sec.
Anh.	<u>885</u>			SE NW NW
Tp.				
H.	<u>2998</u>		<u>1115</u>	CORRECTION ²
Tr.				
Dg.				
Bl.				
L.				
K.C.	<u>3077</u>		<u>1194</u>	Geol.
B.K.C.				Contr.
Ce.				<u>East Drlg.</u>
C.				
M.				Pool
M.				
K.				<u>Trapp</u>
Mz.				
Ma.				
V.				
S.				
S.				
A.	<u>3340</u>		<u>1457</u>	
R.				
Pe.				
G.				
TD.	<u>3341</u>		<u>1458</u>	

Date Comm. 4-28-55 52 @ 1458 JUN 1 19558" @ 210 w/ 150 5 1/2" @ 3341 DD 33428/ 3337-39 250 A S/ 11 boph1 bwph 4 hr. Comp. 25 bopd 5 bw

Russell KANSAS
 SEC. 34 TWP. 15 R. 13 W
 WELL NO. #3 Berry FARM

COMPANY

Michaelis Operations

CONTRACTOR

Mast Drlg.

Trapp Pool


Ft. from N. Line

Ft. from S. Line

Ft. from E. Line

Ft. from W. Line

SE NW NW

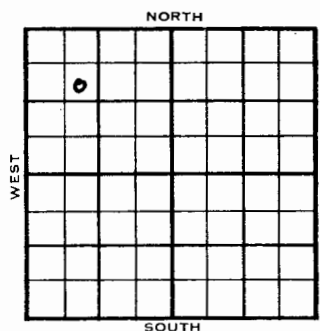

ELEVATION

REPORT

1955 1883'

6/1

Comm. 4-28-555 1/2" @ 14588" @ 210 w/1505 1/2" @ 3441 DD 3342'8/3337-39, 250 A S/11 BOPH

1 BWPH 4 hr.

Comp. 25 BOPD 5 BW

Anh. 885', H. 2998', K.C. 3077',

A. 3340', TD 3341' Comp.

FIRST REPORT

COMPLETED

DX 78-1

Russell

KANSAS

Section 34 Township 15 Range 113W

Well No. #3 Berry

Company Michaelis Operations

