

Map No. _____ Sec. 34 Twp. 15 R. 13W

Well No. 1 Berry

Keyes Drlg. _____ Company

Contractor

SE SW NW

SECTION PLAT



_____ Ft. from N. Line

330 Ft. from S. Line

_____ Ft. from E. Line

990 Ft. from W. Line

Russell County

Location _____

Rig up _____

Drilling and Remarks:

R U R

RECORD

Cased _____ in., _____ ft.

Sand _____

Gas _____

Oil _____

Total Depth _____

PRODUCTION

1st 24 hrs. Nat. _____

1st 24 hrs. after shot _____

Gas _____ Cu. Ft.

Dry Hole _____

Abandoned _____

Date

MAR 1 1930 19 J. E. TYRA Scout

Map No. _____ Sec. 34 Twp. 15 R. 13W


Well No. 1 Berry

Keyes Drlg. _____ Company

Contractor

SE SWNW

E1.1876
SECTION PLAT

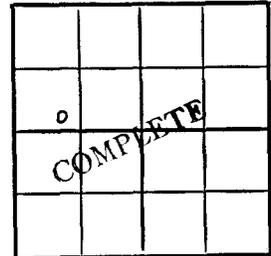

_____ Ft. from N. Line

330 Ft. from S. Line

_____ Ft. from E. Line

990 Ft. from W. Line

Russell County

Location _____

Rig up _____

Drilling and Remarks:

8" c 152
 anhy. 838
 Nelson 2990
 Lane. 3069
 arb. 3328
 5" c 3329
 T.D. 3331

RECORD

Cased _____ in., _____ ft.

Sand _____

Gas _____

Oil _____

Total Depth 3331

PRODUCTION

1st 24 hrs. Nat. _____

1st 24 hrs. after shot _____

Gas _____ Cu. Ft.

Dry Hole _____

Abandoned _____

Date

APR 26 1930 19 J. E. TYRA Scout

Russell

KANSAS

Sec. 34 Twp. 15 R. 13W

Well No. #1 Berry Farm

Keyes Drlg. Company

Contractor

Trapp Pool


Ft. from N. Line

330' Ft. from S. Line

Ft. from E. Line

990' Ft. from W. Line

SE SW NW

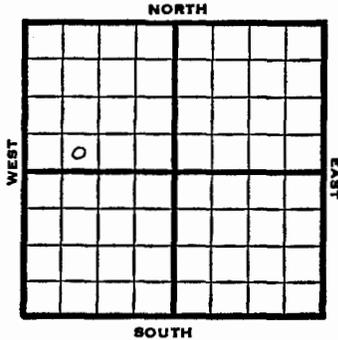

1950 Elev 1876' REPORT

3/1 RUR

4/26 TD 3331'
 8" @ 152'
 Anhy 838'
 Heebner 2990'
 Lans 3069'
 Arb. 3328'
 5" @ 3329'
 TD 3331
 FU 400' Oil in 1 1/2 hrs.
 Comp 159 BOPD
 Comp

COMPLETED

KANSAS Russell County

Trapp Pool

Section 34 Township 15 Range 13-W

Well No. #1 Berry

Company Keyes Drlg

