Form 28—1M Bks—9-28

Map No. 73 Sec. 34 Twp. 15 R. 13W

Well No. 1-Weiko

Shelly Oil Company

Contractor

FIRST REPORTS


SECTION PLAT

330 Ft. from N. Line

Ft. from S. Line

330 Ft. from E. Line

Ft. from W. Line

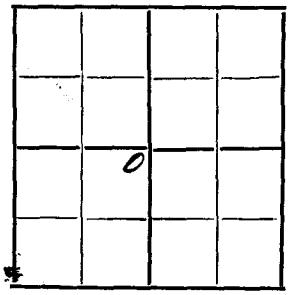

Location ✓

Rig up

Drilling and Remarks:

RECORD

Cased in., ft.

Sand

Gas

Oil

Total Depth

PRODUCTION

1st 24 hrs. Nat.

1st 24 hrs. after shot

Gas Cu. Ft.

Dry Hole

Abandoned

Date 5-28-35 192

ORVAL MANNSCHRECK Scout

Form 28—1M Bks—9-28

Map No. 73 Sec. 34 Twp. 15 R. 13W

Well No. 1-Weiko

Shelly Oil Company

Contractor


SECTION PLAT

330 Ft. from N. Line

Ft. from S. Line

330 Ft. from E. Line

Ft. from W. Line

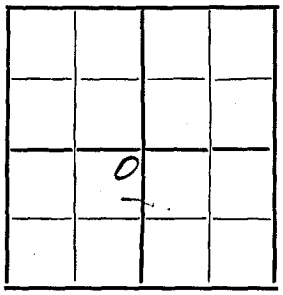

Location

Rig up

Drilling and Remarks:

291 flo

RECORD

Cased in., ft.

Sand Lit 3318

Gas

Oil

Total Depth 3323

PRODUCTION

1st 24 hrs. Nat.

1st 24 hrs. after shot

Gas Cu. Ft.

Dry Hole

Abandoned

Date 8-14-35 192

ORVAL MANNSCHRECK Scout

Form 252-A
5M 7-34 MPC

Russell

Map No. _____ Sec. 34 Twp. 15 R. 13W

Well No. 1 - Weeks Farm


Skelly Oil Company

330 Ft. from N. Line

_____ Ft. from S. Line

330 Ft. from E. Line

_____ Ft. from W. Line

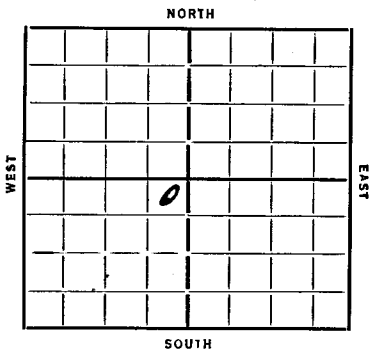

Elev. 1860

Date	REPORT
1935	
5/28	Location
6/6	—
6/13	Rgn
6/20	SJ 260
6/28	Jay Tools 560
7/3	Duley 815 10" 825
	Dely 1600
7/11	" 2575 8" 2458
7/18	" 2795 8" 2538 Top 2750
7/25	Oswald 3060 6" 3080
8/1	678 3317 Lib 3318-19 S.O.
	WOC
8/8	TJ 3323 3000' 12 hrs
	Swab 90 Bbls 6 hrs Tubg.
8/14	Lib 3318
	TJ 3323
	291 Bbls.
	COMPLETED


Form 51—5M 8-35 Mid-West

Russell

Map No. KANSAS Sec. 34 Twp. 15 R. 13W

Well No. 1 - Weeks Farm

Skelly Oil Co. Company

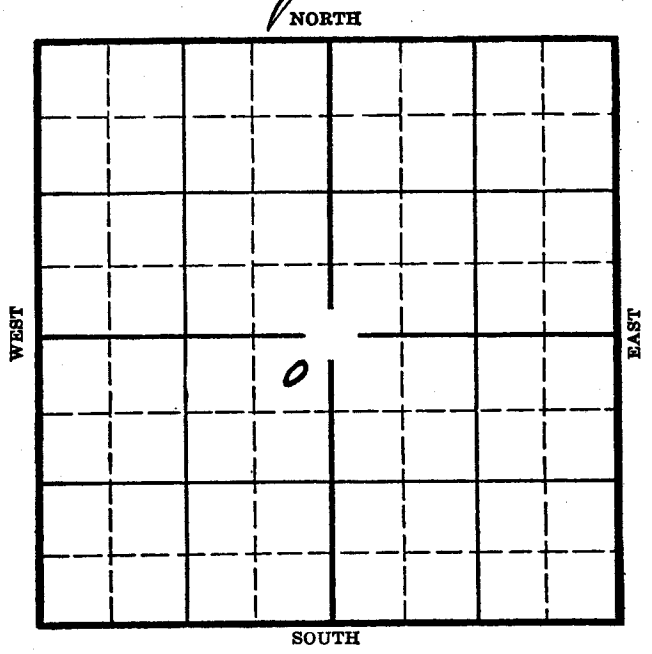

Location

Drilling Remarks

Rig Up

Drilling Remarks

RECORD

Cased _____ in. _____ ft.

Sand

Gas

Oil

Total Depth

PRODUCTION

1st 24 hrs. Nat.

1st 24 hrs. after shot

Gas _____ cu. ft.

Dry Hole

Abandoned