

Russell

KANSAS

Sec. 34 Twp. 15 R. 13 W /

Well No. # 1 Eichman Farm

Dizdar Inv. Company

Contractor

Tropp


890 Ft. from N. Line

Ft. from S. Line

Ft. from E. Line

800 Ft. from W. Line

SE NW SE

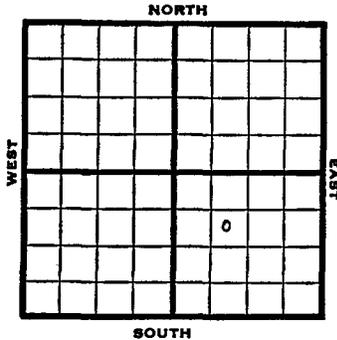


KANSAS

Section 34 Township 15 Range 13W

Well No. #1 Eichman

Company Dizdar Inv.

NORTH

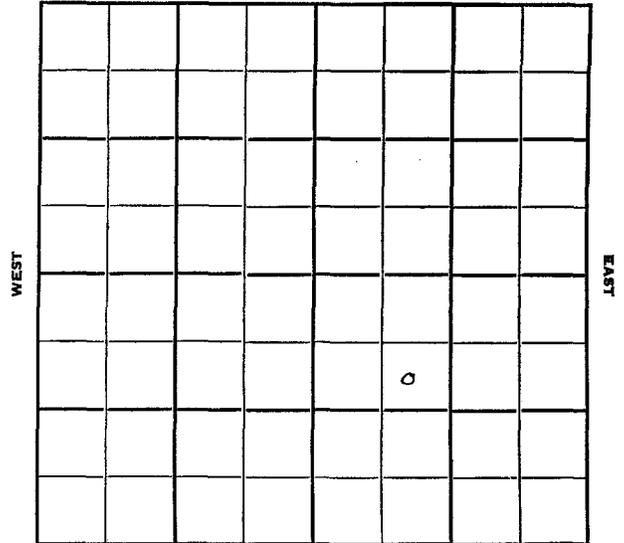

SOUTH

1951 Elev. 1869' REPORT

10/10 Location
 10/24 10-3-51
 D&A TD 3362
 8" @ 260
 Anhy 820 Lans. 3065
 Tarkio 2411 Top. 2983
 Br. lm. 3065 Lans. 3074
 Arb. 3328
 DST 3322-37 open 1/2 hr. rec. 1860'
 wtr.
 TD 3362
 D&A

ABANDONED