

KANSAS

Map No. _____ Sec. 35 Twp. 15 R. 13W

Map No. _____ Sec. 35 Twp. 15 R. 13W

Well No. 1 Krug

Well No. 1 Krug

Helmerich & Payne Company


Helmerich & Payne Company

FIRST REPORT Contractor

ABANDONED Contractor

SECTION PLAT


C E L N E S W
660 Ft. from N. Line
____ Ft. from S. Line
330 Ft. from E. Line
____ Ft. from W. Line

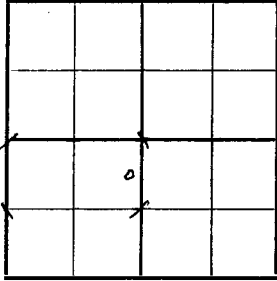

CORALENA POOL

C E L N E S W
660 Ft. from N. Line
____ Ft. from S. Line
330 Ft. from E. Line
____ Ft. from W. Line

SECTION PLAT

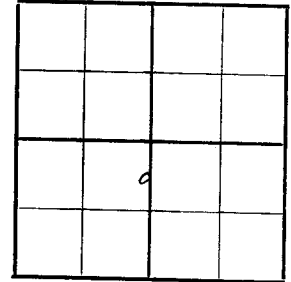

CORALENA POOL

Location _____

RECORD

Cased _____ in., _____ ft.
Sand _____
Gas _____
Oil _____
Total Depth _____

Location _____

RECORD

Cased _____ in., _____ ft.
Sand _____
Gas _____
Oil _____
Total Depth 3350

Rig up _____

Drilling and Remarks:

10" - 122

Drlg. 365

Rig up _____

Drilling and Remarks:

*Cu & 3322
7" @ 3323
500 acid
Water.*

PRODUCTION

1st 24 hrs. Nat. _____
1st 24 hrs. after shot _____
Gas _____ Cu. Ft.
Dry Hole _____
Abandoned _____

PRODUCTION

1st 24 hrs. Nat. _____
1st 24 hrs. after shot _____
Gas _____ Cu. Ft.
Dry Hole _____
Abandoned ✓

Date

Date

AUG 8 1941 19 S. J. LEWIS Scout

SEP 3 1941 19 S. J. LEWIS Scout

Sec. 35 Twp. 15 R. 13-W

Well No. #1 Krug Farm _____
 Company Helmerich & Payne
 (Coralena Pool)


660 Ft. from N. Line

_____ Ft. from S. Line

330 Ft. from E. Line

_____ Ft. from W. Line

Elev. 1853

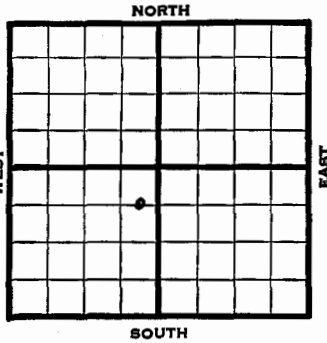

1941	REPORT
8/6	10" - 122 Drlg. 365'
8/15	Topeha 2745' Drlg. 2870'
8/21	Lens. 3057' Arb. 3322-31' T.D. 7" - 3323' RUST.
8/28	T.D. 3350' 2 B.W. $\frac{1}{4}$ bbls. oil per hour. Shut down.
9/3	Arb. 3322' 7" - 3323' T.D. 3350' 500 acid. Water.
ABANDONED	

Section 35 Township 15 Range 13-W

Well No. #1 Krug

Company Helmerich & Payne
 (Coralena)

