

FORM 252-B Russell
 Sec. 35 Twp. 15 R. 13W KANSAS ✓

Well No. 9 Sellens Farm

Sunray Oil Company

Mouser Drlg. Contr. Contractor

Trapp Pool


330 Ft. from N. Line

Ft. from S. Line

Ft. from E. Line

330 Ft. from W. Line


NW NW SE

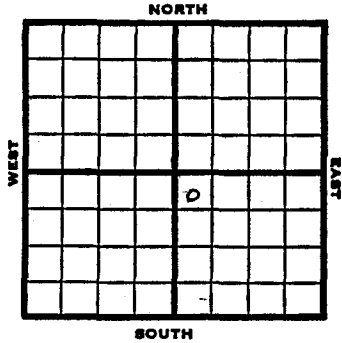

FORM 51 Russell KANSAS
 Section 35 Township 15 Range 13W

Well No. 9 Sellens

Company Sunray Oil Company

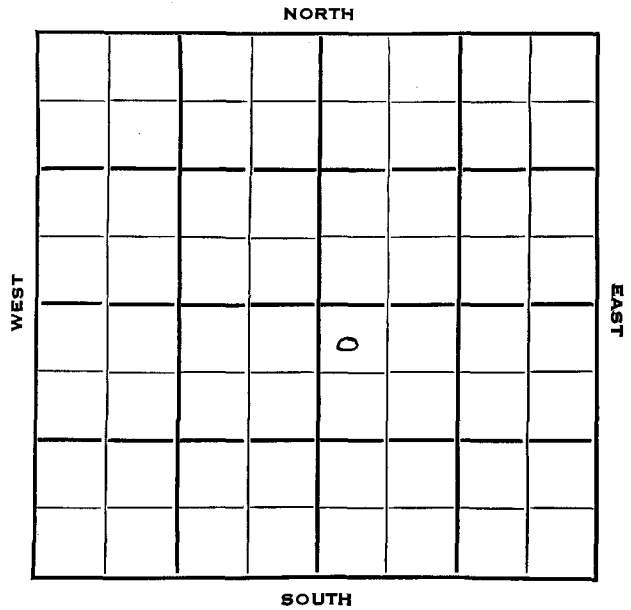

1953 Elev. 1868' REPORT

1/7 Spudding 1/4/53
 8" @ 553 WOC
 1/22 Br Li 3064' Lans. 3074' Arb. 3333'
 RTD 3335' 5" @ 3334 CO 3335
 FU 2000' oil 3 hrs.

1/28 Spud 1-4-53
 OilWell
 TD 3335
 8" @ 553
 Br Line 3064, Lans 3074, Arb.
 3333
 TD 3335
 5" @ 3334
 CO to 3335
 FU 2000' oil 3 hrs.
 Comp. 85 bopd

COMPLETED