

Russell

KANSAS

Sec. 35 Twp. 15 R. 13W


County Russell State Kansas

Sec. 35 (Bk. Twp.) 15 (Sur. Rge.) 13W Map No.

Operator Sunray

Well No. 7 Farm Sellens

Elev. 1860 Location NW SW NE

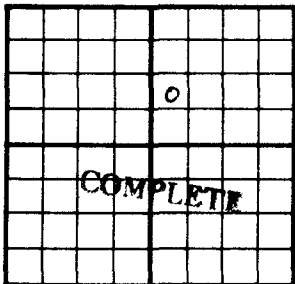

990 Ft. From S Line NE

330 Ft. From W Line Quarter

1st. Report

Completion DEC 10 1952

Remarks

Stickle Drlg. - Contr.

Spudding Date 11-10-52

Drlg. Data Oil well TD 3322

8" @ 550 Lans. 3065 DST 3135-55

open 1 hr. Rec. 350' mud & sw

Arb. 3320 TD 3322 5" @ 3321

CO to 3322 196 bo 10 hr.

Comp. 147 bopd

J. G. McGEHEE

Well No. #7 Sellens Farm

Sunray Company

Stickle Drlg. Contractor


_____ Ft. from N. Line

990 Ft. from S. Line

_____ Ft. from E. Line

330 Ft. from W. Line

~~NW 1/4 NW SW NW~~
NW SW NE

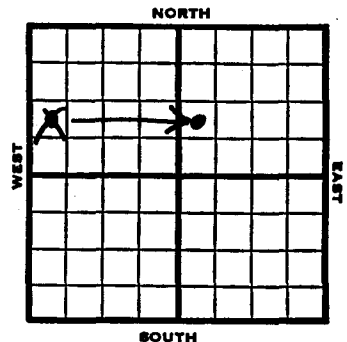

1952 Elev. 1860' REPORT

11/12 Spud 11-10-52
8" @ 550'
Drlg. 1265'

11/20 Lans. 3065'
DST 3135-55, 1 hr, 350' M & SW
Arb. 3320' RTD 3322 5" @ ?

11/27 CO 3322
196 BO 10 hrs.

12/4 NR

12/10 Spud 11-10-52
Oil well TD 3322' 8" @ 550
Lans. 3065
DST 3135-55 open 1 hr. rec 350' mud
& SW Arb. 3320' TD 3322 5" @ 3321
CO to 3322 196 BO 10 hr.
Comp. 147 BOPD

COMPLETED

Section 35 Township 15 Range 13W

Well No. #7 Sellens

Company Sunray

