



Map No. \_\_\_\_\_ Sec. 35 Twp. 15 R. 13W  
Well No. 4 S. J. Sellens


Sec. 35 Twp. 15 R. 13W  
Well No. #4 ~~#3~~ S. J. Sellens Farm  
Sunray Company

**CORRECTION**

NE SE NE

*E. 1869*

**SECTION PLAT**

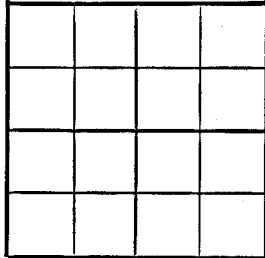

\_\_\_\_\_ Ft. from N. Line  
990 Ft. from S. Line  
330 Ft. from E. Line  
\_\_\_\_\_ Ft. from W. Line

Russell County

Location \_\_\_\_\_  
Rig up \_\_\_\_\_  
Drilling and Remarks:  
Completed  
9-13-50  
#3 S. J. Sellens  
*Correct From #3 to #4*

**RECORD**

Cased \_\_\_\_\_ in., \_\_\_\_\_ ft.  
Sand \_\_\_\_\_  
Gas \_\_\_\_\_  
Oil \_\_\_\_\_  
Total Depth \_\_\_\_\_

**PRODUCTION**

1st 24 hrs. Nat. \_\_\_\_\_  
1st 24 hrs. after shot \_\_\_\_\_  
Gas \_\_\_\_\_ Cu. Ft.  
Dry Hole \_\_\_\_\_  
Abandoned \_\_\_\_\_

Date

SEP 27 1950 19

**J. E. TYRA**


Scout

**Trapp Pool**

\_\_\_\_\_ Ft. from N. Line  
990' Ft. from S. Line  
330' Ft. from E. Line  
\_\_\_\_\_ Ft. from W. Line

NE SE NE

**Oil Well**

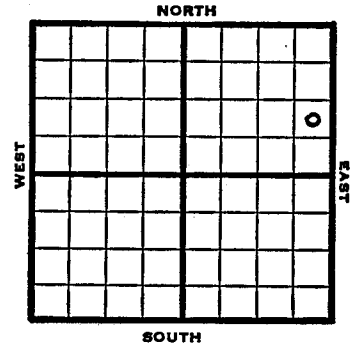

1950

**Elev 1869**

**REPORT**

8/16 RUR  
9/13 Spud 8-15-50  
8" @ 519  
Top 2734 Heeb 2972  
Toronto 2988 Lans 3063  
DST 3133-70 op 1 hr rec 150' SW  
Arb 3322-27  
5" @ 3323 TD 3327  
FU 300' oil 1 hr  
S/4 boph COmp 98 bopd  
TD 3327  
Completed

**COMPLETED**

KANSAS

Russell

Section 35 Township 15 Range 13-W

Well No. #4 ~~#3~~ S. J. Sellens

Company Sunray

