

County **Russell** State **Kansas**
 Sec. **35** (Blk. **15** (Sur. **1 SW** Map No.
 Operator **Sunray**
 Well No. **2** Farm **Tom Sellens**
 Elev. Location **NE NW NW**

0				

330 Ft. From **N** Line **NW**
990 Ft. From **W** Line Quarter
 1st. Report **MAR 19 1952**
 Completion
 Remarks
Stickle Drlg. - Contr.
 Spudding Date **3-15-52**

Drlg. Data
8" @ 529 drlg. 1125

J. G. McGEHEE

County **Russell** State **Kansas**
 Sec. **35** (Blk. **15** (Sur. **13W** Map No.
 Operator **Sunray**
 Well No. **2** Farm **Tom Sellens**
 Elev. **1813** Location **NE NW NW**

0				

330 Ft. From **N** Line **NW**
990 Ft. From **W** Line Quarter
 1st. Report
 Completion **APR 2 1952**
 Remarks
Stickle Drlg. - Contr.
 Spudding Date **3-15-52**

Drlg. Data **D & A TD 3329**
8" @ 529 KC 3031 DST 3034-40 open 1 hr
 Rec. 28' mud DST 3054-62 open 1 hr.
 Rec. 12' mud Cong. 3274 Arb. 3304
 TD 3329

D & A

J. G. McGEHEE

Russell

KANSAS

Sec. 35 Twp. 15 R. 13W

Well No. #2 Tom Sellens Farm

Sunray Company

Contractor


330 Ft. from N. Line

Ft. from S. Line

990 Ft. from E. Line

Ft. from W. Line

NE NW NW

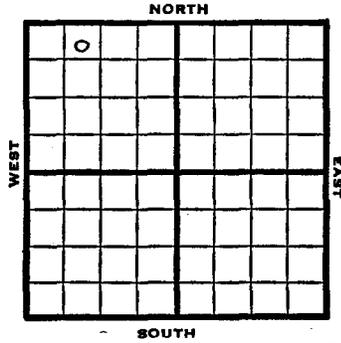

Russell


KANSAS

Section 35 Township 15 Range 13 W

Well No. # 2 Tom Sellens

Company Sunray

NORTH

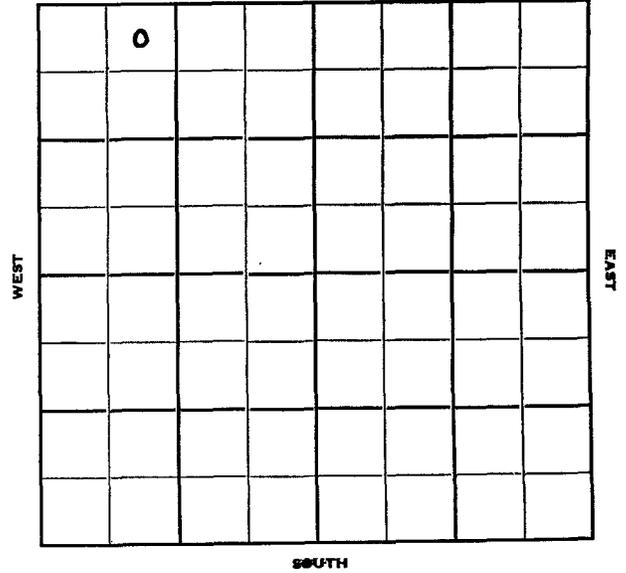

1952 Elev. 1813' REPORT

3/19 Spud 3-15-52
8" @ 529'
Drlg. 1125'

4/2 Spud 3-15-52
D&A TD 3329
8" @ 529
KC 3031
IST 3034-40 opn 1 hr.
Rec. 28' mid DST 3054-62 opn 1 hr.
Rec. 12' mid Cong. 3274 Arb. 3304
TD 3329 D&A

ABANDONED