

J. E. TYRA

J. E. TYRA

Russell

KANSAS

Sec. 36 Twp. 15 R. 13W ✓

Well No. #8 Sellers Farm

Sunray Oil Company

Contractor

Trapp Pool


Ft. from N. Line

990' Ft. from S. Line

660' Ft. from E. Line

Ft. from W. Line

C N/2 SE NW

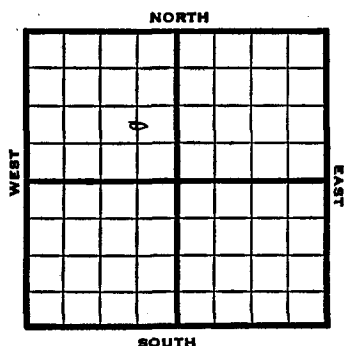


KANSAS

Section 36 Township 15 Range 13 W

Well No. # 8 Sellers

Company Sunray Oil

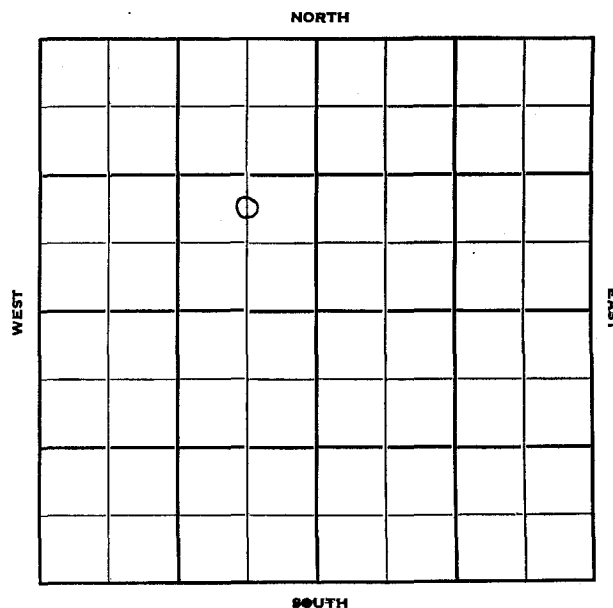

1951 Elev. 1895' REPORT

6/27 RUR
8/8 Spud 6-26-51
Oil Well TD 3366

8" @ 539

Lans. 3088

DST 3261-68 opn 1 hr Rec. 15' mud

Arb. 3356 5" @ 3358

TD 3366 350 A S/3 boph

500 A Comp. 98 bopd

COMPLETED