

STATE CORPORATION COMMISSION OF KANSAS
OIL & GAS CONSERVATION DIVISION

WELL COMPLETION OR RECOMPLETION FORM
ACO-1 WELL HISTORY

DESCRIPTION OF WELL AND LEASE

Operator: License # 6246
Name Bennett & Schulte Oil Company
Address 112 W. 7th St., Box 329
City/State/Zip Russell, Kansas 67665

Purchaser C. J. & P. Petroleum Corp.
Tulsa, OK

Operator Contact Person Reginald Bennett or
Phone 913 483-2721 Ralph Schulte

Contractor: License # 9431
Name Vonfeldt Drilling Company

Site Geologist Brad Hutchison
Phone 913 483-6637

Designate Type of Completion

☐ New Well ☐ Re-Entry ☐ Workover

☒ Oil ☐ SWD ☐ Temp Abd
☐ Gas ☐ Inj ☐ Delayed Comp.
☐ Dry ☐ Other (Core, Water Supply etc.)

If OWWO: old well info as follows:

Operator
Well Name
Comp. Date Old Total Depth.....

WELL HISTORY

Drilling Method:

☒ Mud Rotary ☐ Air Rotary ☐ Cable

6/19/85 6/25/85 6/25/85
.....
Spud Date Date Reached TD Completion Date
3375'
Total Depth PBTD

Amount of Surface Pipe Set and Cemented at 705' feet
Multiple Stage Cementing Collar Used? ☐ Yes ☐ No
If yes, show depth set feet
If alternate 2 completion, cement circulated
from feet depth to w/ SX cmt

API NO. 15-..... 167-22,621

County..... Russell

SW NW NE Sec. 4 Twp. 15 Rge. 13 ☐ East
..... ☒ West


4290' Ft North from Southeast Corner of Section
2310' Ft West from Southeast Corner of Section
(Note: Locate well in section plat below)

Lease Name..... Heffernan Well #..... 3

Field Name..... Trapp

Producing Formation..... L-KC

Elevation: Ground..... 1720' KB..... 1725'
Section Plat

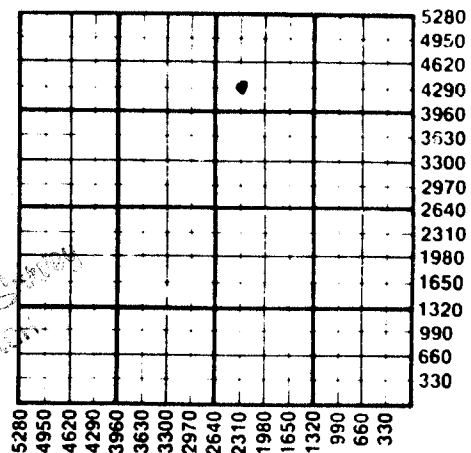

WATER SUPPLY INFORMATION

Disposition of Produced Water: ☒ Disposal
Docket # ☐ Repressuring

Questions on this portion of the ACO-1 call:

Water Resources Board (913) 296-3717

Source of Water:

Division of Water Resources Permit #.....

☐ Groundwater..... Ft North from Southeast Corner
(Well) Ft West from Southeast Corner of
Sec Twp Rgn ☐ East ☐ West

☐ Surface Water..... Ft North from Southeast Corner
(Stream, pond etc)..... Ft West from Southeast Corner
Sec Twp Rge ☐ East ☐ West

☐ Other (explain).....
(purchased from city, R.W.D. #)

INSTRUCTIONS: This form shall be completed in duplicate and filed with the Kansas Corporation Commission, 100 Colorado Derby Building, Wichita, Kansas 67202, within 90 days after completion or recompletion of any well. Rule 82-3-130 and 82-3-107 apply.

Information on side two of this form will be held confidential for a period of 12 months if requested in writing and submitted with the form. See rule 82-3-107 for confidentiality in excess of 12 months.

One copy of all wireline logs and drillers time log shall be attached with this form. Submit CP-4 form with all plugged wells. Submit CP-111 form with all temporarily abandoned wells.


Operator Name Bennett & Schulte Oil Company Lease Name Heffernan Well # 3

Sec. 4 Twp. 15S Rge. 13 ☐ East ☒ West County Russell

Estimated Production Per 24 Hours	25 BOPD	10%	37
	Bbls	MCF	Bbls CFPB

METHOD OF COMPLETION

Disposition of gas: ☐ Vented ☐ Open Hole ☒ Perforation
☐ Sold ☐ Other (Specify)
☐ Used on Lease

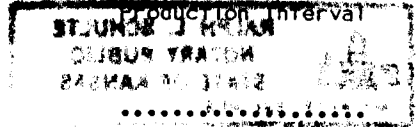

Drill Stem Tests Taken ☐ Yes ☒ No
 Samples Sent to Geological Survey ☐ Yes ☒ No
 Cores Taken ☐ Yes ☒ No

Formation Description

☐ Log ☐ Sample

Name	Top	Bottom
Anhydrite	682	
1st Tarkio Sand	2256	
Tarkio Lime	2316	
Topeka	2593	
Heebner	2823	
Toronto	2842	
Lansing	2890	
B/KC	3157	
Conglomerate	3187	
Arbuckle	3220	
Quartz	3332	
Rotary TD	3375	
Log TD	3376	

CASING RECORD ☒ New ☐ Used

Report all strings set-conductor, surface, intermediate, production, etc.

Purpose of String	Size Hole Drilled	Size Casing Set (in O.D.)	Weight Lbs/Ft.	Setting Depth	Type of Cement	#Sacks Used	Type and Percent Additives
Surface Pipe	12 1/4	8 5/8	24	705	Poz	325	
Production	7 7/8	5 1/2	14	3275	Poz	250	

PERFORATION RECORD

Acid, Fracture, Shot, Cement Squeeze Record

Shots Per Foot	Specify Footage of Each Interval Perforated	(Amount and Kind of Material Used)	Depth
4	2927 to 2934	1,000 Gals Acid	2927 to 2934

TUBING RECORD

Size
2 3/8"

Set At
2950

Packer at

Liner Run

☐ Yes ☒ No

Date of First Production Producing Method

July 17, 1985

☐ Flowing ☒ Pumping ☐ Gas Lift ☐ Other (explain).....

Oil

Gas

Water

Gas-Oil Ratio

Gravity