

8-15-18W

KANSAS WELL LOG BUREAU --- KANSAS GEOLOGICAL SOCIETY
508 EAST MURDOCK - WICHITA, KANSAS

COMPANY M. B. ARMER

SEC. 8 T. 15 R. 18W
LOC. SE SE NW

FARM Rohr

NO. 1

TOTAL DEPTH 3610

COMM. 12-15-50

COMP. 12-30-50


SHOT OR TREATED

CONTRACTOR Armer Drlg. Co., Inc.

ISSUED 1-20-51

COUNTY Ellis

KANSAS

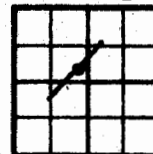

CASINO

8 5/8" 163'

ELEVATION 2008 Ind. RB.
2006 DF

PRODUCTION dry

FIGURES INDICATE BOTTOM OF FORMATIONS

shale & shells	564
sand, shale & shells	760
shale, redbed & shells	1080
shale & shells	1143
Anhydrite	1176
shale & shells	1340
redbed, shale & shells	1665
salt & shale	1700
shale & shells	1905
shale & lime	2480
shale & lime shells	2615
shale & lime	3200
lime	3250
lime & shale	3295
lime	3312
lime & shale	3378
lime	3610
Total depth	

Tops: R. B. Meas.

Heebner 3235

Kansas City 3281

Conglomerate 3572

Arbuckle 3599

Elevation: 2003 Gr.
2009 RB

Ellis

KANSAS

Sec. 8 Twp. 15 R. 18W

Well No. #1 Rohr Farm

M. B. Armer Company

Contractor


Ruder Pool

Ft. from N. Line

330' Ft. from S. Line

330' Ft. from E. Line

Ft. from W. Line
SE SE NW

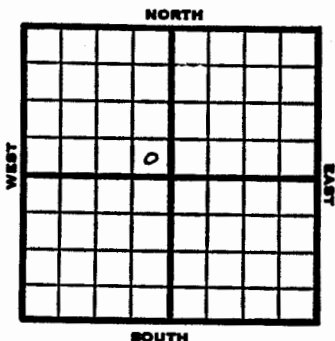

1950 Elev. 2006' REPORT

12/20 Spud 12-16-50
8" @ 162
Anhy 1143-76
Drlg. 2310'

1951
1/3 Spud 12-16-50
D&A TD 3610
8" @ 162 Anhy 1143-76
Heeb. 3235 Lans. 3281
Cong. 3572 Arb. 3599
TD 3610 D&A
ABANDONED

Ellis

KANSAS

Section 8 Township 15 Range 18W

Well No. #1 Rohr

Company M. B. Armer

