

8-15-18W

WELL LOG BUREAU — KANSAS GEOLOGICAL SOCIETY
412 Union National Bk. Bldg., Wichita, Kansas


Company. B & R DRUG. CO.
Farm. Wasinger No. 1.

SEC. 8 T. 15 R. 18 W
NW SE NW

Total Depth. 3635
Comm. 5-26-45
Shot or Treated.
Contractor.
Issued. 9-1-45

Comp. 6-17-45

County. Ellis
KANSAS

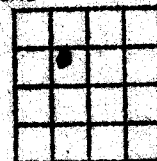

CASING:
13 3/8"
8 5/8"
5 1/2"

115' Cem.
1150' Cem.
3635' Cem.

Elevation. _____

Production. Pot. Pump. 45 BO
20 BW

Figures Indicate Bottom of Formations.

sub soil & clay	30
shale & shells	70
shale sdy & shells	110
shale, shells, & iron, lime	130
shale	180
shale & shells	245
sand & shale	345
shale & shells	365
sand & shale	385
shale & shells	410
pyrite sdy & shale	455
sand & shale	535
shale & shells	560
sand & shale	600
sand	820
red bed & sand	860
shale & pyrite	900
shale & shells	935
red rock & pyrite	1125
red bed & shells	1170
anhydrite	1220
red bed & shells	1255
shale & shells	1650
salt	1755
shale & salt	1865
shale & shells	1895?
shale & lime	1870?
shale	2005
lime	2070
lime & shale	2290
lime	2355
shale & lime	2585
lime	2605
shale & lime	3090
lime	3240
shale & lime	3255
lime	3575
cherty conglomerate	3585

Shale 3,595

Cherty
Conglomerate 3,611

Lime 3,635

KANSAS

Ellis

Sec. 8 Twp. 15 R. 18WWell No. 1 Wasinger Farm

Woodriver etal Company


Madden

Ft. from N. Line

850 Ft. from S. Line850 Ft. from E. Line

Ft. from W. Line

NW SE NW Elev. 2012

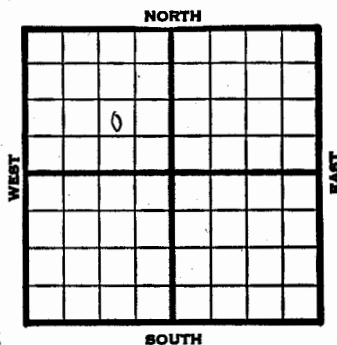

1945


REPORT

5/23 Location
5/31 "
6/8 13" @ 130 Anhy 1170 8" @ 1174
Drlg. 1895
6/14 Drlg. 3125
6/21 Arb 3601-3620 TD
5" @ 3620 RUST
6/28 24 shots 3598-3604
swb 5 oil PH
7/3 " " " " "
7/11 " " " " "
7/19 " " " " "
7/26 Pump 40 oil a day
8/15 Arb 3601
5" @ 3620
Perf. Arb.
TD 3620
Pump 45 oil plus 20 W Pot.
Grav. 28.0

COMPLETED

Kansas Pool Name MaddenMap No. 74 Sec. 8 Twp. 15 R. 18WWell No. 1 WasingerWoodriver etal CompanyFIRST REPORT Contractor
NW SE NW

SECTION PLAT

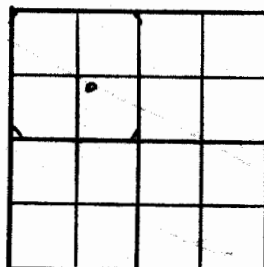

Ft. from N. Line

850 Ft. from S. Line850 Ft. from E. Line

Ft. from W. Line

EllisLocation X

Rig up

Drilling and Remarks:

RECORD

Cased in, ft.

Sand

Gas

Oil

Total Depth

PRODUCTION

1st 24 hrs. Nat.

1st 24 hrs. after shot

Gas Cu. Ft.


Dry Hole

Abandoned

Date

MAY 23 1945 19 S. J. LEWIS ScoutKansas Pool Name MaddenMap No. 74 KANSAS Sec. 8 Twp. 15 R. 18WWell No. 1 WasingerWoodriver etal CompanyCOMPLETED ContractorNW SE NWE1,2012

SECTION PLAT

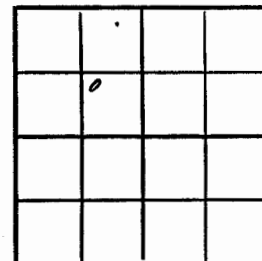

Ft. from N. Line

850 Ft. from S. Line850 Ft. from E. Line

Ft. from W. Line

Ellis County

Location

Rig up

Drilling and Remarks:

Per 736015" @ 3620Per art.Per 45 oil 720Per280

RECORD

Cased in, ft.

Sand

Gas

Oil

Total Depth 3620

PRODUCTION

1st 24 hrs. Nat.

1st 24 hrs. after shot

Gas Cu. Ft.



Dry Hole

Abandoned

Date

AUG 15 1945 19 S. J. LEWIS Scout

1871X (177)

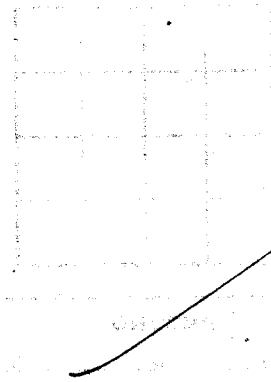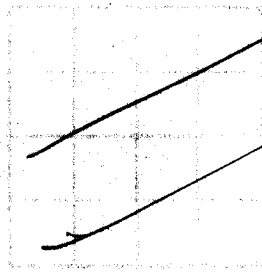

Misc. Small Maps	
Cards	<i>RB</i>
Tracing	<i>RB</i>
France Map	<i>RB</i>
Scarborough Map	<i>RB</i>
Pierce Map	<i>RB</i>
Geological Dept.	
Pierce Plat Book	

Misc. Small Maps	<i>RB</i>
Cards	<i>RB</i>
Tracing	<i>RB</i>
France Map	<i>RB</i>
Scarborough Map	<i>RB</i>
Pierce Map	<i>RB</i>
Geological Dept.	
Pierce Plat Book	