

Pool Name WildcatMap No. 74 Sec. 2 Twp. 15 R. 18WWell No. PfannenstielSunray Oil

Company

FIRST REPORT

Contractor

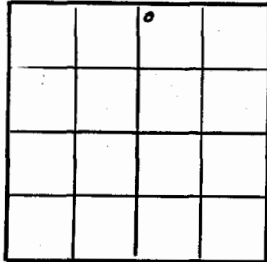
NW NE

SECTION PLAT

330 Ft. from N. Line

Ft. from S. Line

Ft. from E. Line

330 Ft. from W. LineEllisLocation X

RECORD

Cased in ft.

Sand

Gas

Oil

Total Depth

PRODUCTION

1st 24 hrs. Nat.

1st 24 hrs. after shot

Gas Cu. Ft.

Dry Hole

Abandoned

Date

NOV 15 1944

19

S. J. LEWIS

Scout

Pool Name WildcatMap No. 74 Sec. 2 Twp. 15 R. 18WWell No. 1 PfannenstielIron Drlg.

Company

CORRECTION

Contractor

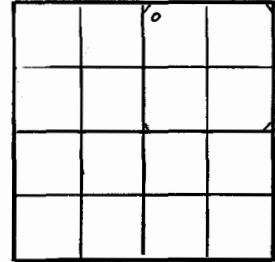
NW NE

SECTION PLAT

330 Ft. from N. Line

Ft. from S. Line

Ft. from E. Line

330 Ft. from W. LineEllis County

Location

RECORD

Cased in ft.

Sand

Gas

Oil

Total Depth

PRODUCTION

1st 24 hrs. Nat.

1st 24 hrs. after shot

Gas Cu. Ft.

Dry Hole

Abandoned

Date

NOV 22 1944

19

S. J. LEWIS

Scout

Pool Name WildcatMap No. 74 Sec. 2 Twp. 15 R. 18WWell No. 1 Pfannenstiel

Iron Drlg. _____ Company

ABANDONED

Contractor

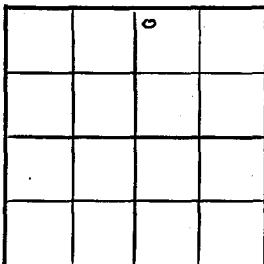
NW NE

SECTION PLAT

330 Ft. from N. Line

_____ Ft. from S. Line

_____ Ft. from E. Line

330 Ft. from W. Line

Ellis County

Location _____

Rig up _____

Drilling and Remarks:

Arb. 3632Lans 3303

RECORD

Cased _____ in., _____ ft.

Sand _____

Gas _____

Oil _____

Total Depth 3666

PRODUCTION

1st 24 hrs. Nat. _____

1st 24 hrs. after shot _____

Gas _____ Cu. Ft.

Dry Hole _____

Abandoned _____

Date

DEC 13 1944 19

S. J. LEWIS Scout

KANSAS

Ellis County

Sec. 2 Twp. 15 R. 18WWell No. # Pfannenstiel FarmSunray Oil Iron Drlg. Company

Wildcat

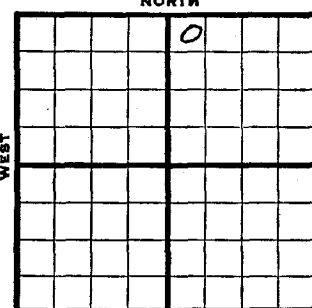
330 Ft. from N. Line

_____ Ft. from S. Line

_____ Ft. from E. Line

330 Ft. from W. Line

NW NE



SOUTH

1944

REPORT

11/15 Location

11/24 R U R

11/29 13" @ 90 Drlg. 1946

12/6 No report

12/13 Arb. 3632
Lans 3303
TD 3666'

ABANDONED

KANSAS

FORM 51 5M BRIX

Ellis County

Section 2 Township 15 Range 18W

Well No. Pfannenstiel

Company Sunray Oil Iron Drilg. Co.

