

County Ellis Elev 2002
 Sec. 2 Twp 15 Rge. 18W
 Company Don Pratt et al.
 Farm Name Peter B. Leiker No. 2 XV

TOPS	DEPTH	LOG	DATUM	Loc. in Sec.
Asb	1120			NE SW NW
Tr				
H. 1/2	3256			
Tr	3277			
Dg				
Bl.				
L.				Geol.
K.C.	3304			
B.K.C.	3527			Conts
Ce.				Armer
C.				
M.				Pool
K.				
Mt.				
Me.				
V.				
S.				
S.				
A	3596			
R.				
PE				
G.				
VS	3607			

DEC 5 '56
 COMPLETE

Date Comm. 9-2-56
 8" @ 208/125 d rlr. SEP 12 '56 11 3395
 SEP 19 '56 DST 3584-3600 1 hr
 net 5' Md BHP 15/30" DST
 5t PKC 3589-3603 90" net
 33' Md BHP 35/30" DST 3602
 -07 net 90" 130' Glean 9554
 oil + 20' Ho 5 6-CM BHP 1065
 100% 5/2 @ 3601 SEP 26 '56 CD 3607
 FU 1500' oil 8 hrs PAP

CODE 370 P. G. Boph m/w l/h
 OCT 10 '56 OCT 17 '56 OCT 24 '56 OCT 31 '56 NOV 7 '56
 NOV 13 '56 NOV 21 '56 NOV 28 '56 DEC 5 '56
Ph V 68 Bopd + 5% w to
gran 34.2°

Ellis

KANSAS

SEC.

2

TWP.

15

R.

18W

WELL NO.

#2 Peter B. Leiker

FARM

COMPANY

Don Pratt et al

CONTRACTOR

Armer

FORM 513 SUNRAY

County Ellis Elev. _____
 Sec. 2 Twp. 15 Rge. 18W
 Company Don Pratt et al.
 Farm Name Peter B. Leiker No. 2


TOPS	DEPTH	LOG	DATUM	Loc. in Sec.
Anh.				NE SW NW
Tr.				
H.				
Tr.				
Dg.				
Bl.				
L.				
K.C.				
B.K.C.				
Geol.				
Ce.				
C.				
M.				
M.				
K.				
Mz.				
Me.				
V.				
S.				
S.				
A.				
R.				
Pe.				
G.				
TD				

Geol. _____
 Contr. Armer
 Pool _____

FIRST REPORT
 SEP 5 '56

Date Comm. 9-2-56
8" @ 208/125 drlg.

14

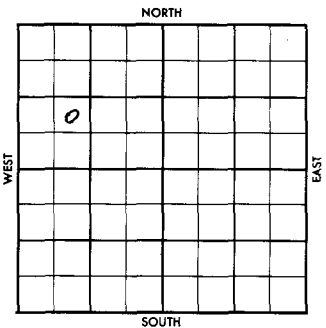

_____ FT. FROM N. LINE
 _____ FT. FROM S. LINE
 _____ FT. FROM E. LINE
 _____ FT. FROM W. LINE

■ NE SW NW

	ELEVATION	REPORT
1956		
9-5		Comm 9-2-56 8" @ 208 w/125 Drlg

Ellis KANSAS

SECTION 2 TOWNSHIP 15 RANGE 18W

WELL NO. #2 Peter B. Leiker

COMPANY Don Pratt etal

