

County Ellis Elev. _____
 Sec. 2 Twp. 15 Rge. 18W
 Company Don Pratt etal
 Farm Name Alex B. Leider No. 1


TOPS	DEPTH	LOG	DATUM	Loc. in Sec.
Anh.				NE NW SW
Sp.				
H.				
Tr.				
Dg.				
Bl.				
L.				Geol.
N.C.				Contr.
B.K.C.				
Ce.				Pool
C.				
M.				
M.				
K.				
Mz.				
Me.				
V.				
S.				
S.				
A.				
R.				
PC.				
G.				

FIRST REPORT
 0
 AUG 29 '56

Date Comm. 8/21/56
8" surf. ser, Drlg 3037 Sped. _____

SEC. 2 TWP. 15 R. 18W

WELL NO. #1 Alex B. Leider LEIKER FARM
 COMPANY Don Pratt, etal
 CONTRACTOR _____

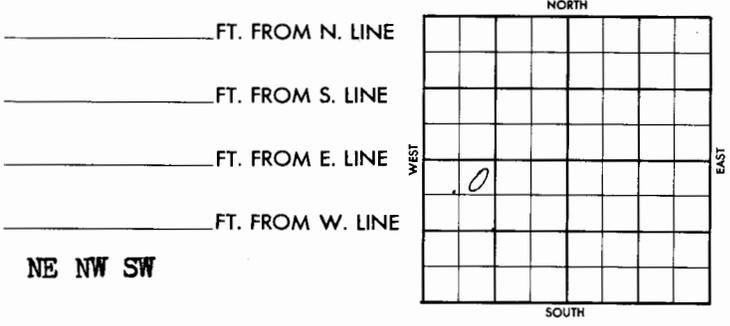

1956	ELEVATION	REPORT
8-29	Comm. 8-21-56 8" @ Drlg. 3037	

DX 78-1 **Ellis**

KANSAS

Section 2 Township 15 Range 18W

Well No. #1 Alex B. Leider LEIKER

Company Don Pratt et al

