

County Ellis Elev. 15
 Sec. 2 Twp. 15 Rge. 18W
 Company Don E. Pratt
 Farm Name John "B" No. 1

TOPS	DEPTH	LOG	DATUM	Loc. in Sec.
Anb.				SW SE SE
Tr.				3600' test
H.				
Tr.				
Dg.				
BL				
L.				Geol.
K.C.				
B.K.C.				Contr.
Ce.				Armer
C.				
M.				Pool
M.				
K.				
Mz.				
Me.				
V.				
S.				
S.				
A.				
R.				
Pe.				
G.				
TD				

FIRST REPORT
 JUN 6 '56

Date Comm.

County Ellis Elev. 2012
 Sec. 2 Twp. 15 Rge. 18W
 Company Don E. Pratt
 Farm Name John "B" Leiker No. 1

TOPS	DEPTH	LOG	DATUM	Loc. in Sec.
Anb.				SW SE SE
Tr.				3600' test
H.	3231			
Tr.	3288			
Dg.				
BL				
L.	3319			Geol.
K.C.				
B.K.C.				Contr.
Ce.				Armer
C.	Charty 3603			
M.				Pool
M.				
K.				
Mz.				
Me.				
V.				
S.				
S.				
A.				
R.				
Pe.				
G.				
TD	3632	3607		

COMPLETE
 ABANDONED
 JUL 18 1956

Date Comm. JUN 13 '56 JUN 20 '56 6-14-56

85/8 590 11 1964 JUN 27 '56

JUL 3 '56 JUL 11 '56 DST 3222-7216


JUL 75' WM BHP 575/20"

JUL 18 '56

D&A (Charty)

Ellis KANSAS
 SEC. 2 TWP. 15 R. 18W
 WELL NO. #1 John "B" Leiker FARM
 COMPANY Don E. Pratt
 CONTRACTOR Armer

FT. FROM N. LINE
 FT. FROM S. LINE
 FT. FROM E. LINE
 FT. FROM W. LINE
 SW SE SE

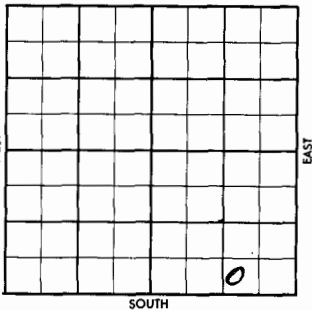

1956 ELEVATION 2012 REPORT 3600' test

6-6 Location
 7-18 Comm. 6-14-56
 8 5/8" @ 590
 DST 3322-72 op 1 hr, rec. 75' ~~W~~
 BHP 575/20"
 D & A
 H. 3271'; Tr. 3288'; L. 3319';
 Cherty 3602'
 TD 3622

ABANDONED

DX 78-1 Ellis

KANSAS

Section 2 Township 15 Range 18W
 Well No. #1 John "B" Leiker
 Company Don E. Pratt

NORTH
 WEST EAST
 SOUTH

