

Ellis KANSAS ✓


Sec. 6 Twp. 15 R. 18 WWell No. # 2 Ryan FarmPetroleum Inc. CompanyGarvie Contractor990 Ft. from N. Line

Ft. from S. Line

Ft. from E. Line

330 Ft. from W. Line

SW NW NW

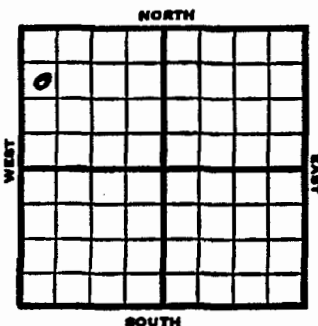

1953

Information brought forward

4/8

CO to 3640 12/3634-38 S/ $\frac{1}{2}$ boph
 6% wtr. 250 A S/ $\frac{1}{4}$ boph
 Comp. 50 bopd 5% wtr.

COMPLETED

1953	Elev. 2035'	REPORT
3/11	Spud 2-27-53 8" @ 195' Heeb 3271' Lans 3317' DST 3320-46 open 1 hr. rec 15' mud Cong 3604' DST 3600-20 open $\frac{1}{2}$ hr. rec 4' mud Off Arb. 3627' DST 3624-48' open 1 hr. rec 180' HOCM 300' oil 975# TD 3648' 5" @ 3647'	
3/19	CO 3640 12/3634-38 S/ $\frac{1}{2}$ BOPH 250 A S/ $\frac{1}{2}$ BOPH 24 hrs 6% wtr. POP	
3/26	NR	
4/2	"	
4/8	Spud 2-27-53 Oil Well TD 3648 8" @ 195' Heeb 3271, Lans 3317, DST 3320-46 open 1 hr. Rec 15' mud Cong 3604, DST 3600-20 open $\frac{1}{2}$ hr. Rec 4' mud, Off Arb 3627, DST 3624-48 open 1 hr. Rec 180' hocom 300' oil 975# TD 3648' 5" @ 3647'	
OVER		

County Ellis State Kansas
 Sec. 6 (Blk. 15) (Sur. 18W) Map No.

Operator Petroleum Inc.

Well No. 2 Farm Ryan

Elev. 2035 Location SW NW NW

990 Ft. From N Line NW

330 Ft. From W Line Quarter

1st. Report MAR 11 1953

Completion

Remarks

Garvie - Contr.

Spudding Date 2-27-53

Drlg. Data

8" @ 195 Heeb. 3271 Lans. 3317

DST 3320-46 open 1 hr. Rec. 15' mud

Cong. 3604 DST 3600-20 open $\frac{1}{2}$ hr.

Rec. 4' mud O# Arb. 3627 DST 3624-48

open 1 hr. Rec. 180' hoom 300' oil

975# TD 3648 5" @ 3647

J. G. McGEHEE

County Ellis State Kansas
 Sec. 6 (Blk. 15) (Sur. 18W) Map No.

Operator Petroleum Inc.

Well No. 2 Farm Ryan

Elev. 2035 Location SW NW NW

990 Ft. From N Line NW

330 Ft. From W Line Quarter

1st. Report

Completion APR 8 1953

Remarks

Garvie - Contr.

Spudding Date 2-27-53

Drlg. Data Oil well TD 3648

8" @ 195 Heeb. 3271 Lans. 3317

DST 3320-46 open 1 hr. Rec. 15' mud

Cong. 3604 DST 3600-20 open $\frac{1}{2}$ hr.

Rec. 4' mud O# Arb. 3627 DST 3624-48

open 1 hr. Rec. 180' hoom 300' oil

975# TD 3648 5" @ 3647 CC to 3640

12/ 3634-38 S/ $\frac{1}{2}$ boph 6% wtr. 250 A

S/ $4\frac{1}{2}$ boph Comp. 50 bopd 6% wtr.

J. G. McGEHEE

FORM 51

Ellis

KANSAS

Section 6 Township 15 Range 18W

Well No. #2 Ryan

Company Petroleum Inc.

