

 FarmName Swires No. 1

TOPS	DEPTH	LOG	DATUM	Loc. in Sec.
Ans.	1205			SE SW SE
Tr.				
H.				
Tr.				
Dg.				
Bl.				
L.				
K.C.				Geol.
B.K.C.				Contr.
Ce.				Co. tools
C.				
M.				Pool
K.				Under
Me.				
Mo.				
V.				
S.				
S.				
A.				
R.				
Pe.				
G.				

FIRST REPORT

Date Comm. 7-11-56 JUL 18 '56
8" @ 1215/350 drlg. 3190

 FarmName Swires No. 1

TOPS	DEPTH	LOG	DATUM	Loc. in Sec.
Ans.	1205			SE SW SE
Tr.	3372			
H.				
Tr.				
Dg.				
Bl.	3326			
L.				Geol.
K.C.				Contr.
Ce.				Co. tools
C.				
M.				Pool
K.				Under
Me.				
Mo.				
V.				
S.				
S.	3637			
A.				
R.				
Pe.				
G.				

ABANDONED
 JUL 25 1956

Date Comm. 7-11-56
8" @ 1215/350 drlg. 3190


O.S.A.

County ELLS Elev. 2035
 Sec. 7 Twp. 15 Rge. 18W
 Company Thunderbird Drlg.
 FarmName Swires No. 1

TOPS	DEPTH	LOG	DATUM	Loc. in Sec.
Anh.	<u>1205</u>			<u>SE SW SE</u>
Tp.				
H.				
Tr.				
Dg.				
Bl.				
L.				
K.C.				Geol.
B.K.C.				Contr.
Ce.				<u>Co. tools</u>
C.				
M.				Pool
M.				<u>Ruder</u>
K.				
Mz.				
Mo.				
V.				
S.				
S.				
A				
R.				
PE				
G.				
TD				

FIRST REPORT

Date Comm. 7-11-56 JUL 18 '56
8" @ 1215/350 drlg. 3190

County ELLS Elev. 2035
 Sec. 7 Twp. 15 Rge. 18W
 Company Thunderbird Drlg.
 FarmName Swires No. 1

TOPS	DEPTH	LOG	DATUM	Loc. in Sec.
Anh.	<u>1205</u>			<u>SE SW SE</u>
Tp.				
H.	<u>3378</u>			
Tr.				
Dg.				
Bl.				
L.	<u>3326</u>			
K.C.				Geol.
B.K.C.				Contr.
Ce.				<u>Co. tools</u>
C.				
M.				Pool
M.				<u>Ruder</u>
K.				
Mz.				
Mo.				
V.				
S.				
S.				
A	<u>3638</u>			
R.				
PE				
G.				
TD	<u>3650</u>			

ABANDONED

JUL 25 1956

Date Comm. 7-11-56
8" @ 1215/350 drlg. 3190 JUL 25 '56

DST 3335-95 1hr 1050' SW
BHP 750/20" DST 3640-50 1hr
885' SW BHP 1070/20"

D & A

Ellis


KANSAS

SEC. 7 TWP. 15 R. 18W

WELL NO. #1 Swires FARM

COMPANY Thunderbird Drlg.

CONTRACTOR Co. Tools Ruder

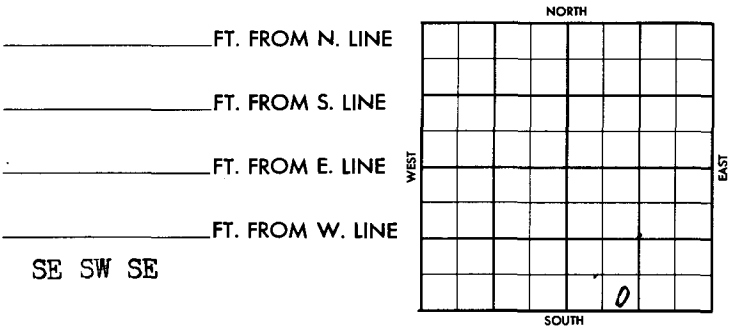

1956 ELEVATION 2035' REPORT

7-18 Comm. 7-11-56
8" @ 1215 w/350
Drlg. 3190
Anh. 1205'

7-25 DST 3335-95 op 1 hr, rec. 1050' SW,
BHP 750/20".
DST 3640-50 op 1 hr. rec. 885' SW,
BHP 1070/20".
D & A
H. 3278'; L. 3326'; A. 3638';
TD 3650'

ABANDONED

DX 78-1 Ellis

KANSAS

Section 7 Township 15 Range 18W

Well No. #1 Swires

Company Thunderbird Drlg

