

Map No. 74 Sec. 8 Twp. 15 R. 18WWell No. 4 Ruder
G. H. Son & Co. Company
Contractor

SECTION PLAT

_____ Ft. from N. Line
990 Ft. from S. Line
 _____ Ft. from E. Line
990 Ft. from W. Line

FIRST REPORT

Location _____
 Rig up _____
 Drilling and Remarks:

RECORD
 Cased _____ in., _____ ft.
 Sand _____
 Gas _____
 Oil _____
 Total Depth _____

PRODUCTION
 1st 24 hrs. Nat. _____
 1st 24 hrs. after shot _____
 Gas _____ Cu. Ft.
 Dry Hole _____
 Abandoned _____

Date APR 15 1936
192 _____ S. J. LEWIS Scout

Map No. 74 Sec. 8 Twp. 15 R. 18WWell No. 4 Ruder
G. H. Son & Co. Company
Contractor

SECTION PLAT

_____ Ft. from N. Line
990 Ft. from S. Line
 _____ Ft. from E. Line
990 Ft. from W. Line

ABANDONED

Location _____
 Rig up _____
 Drilling and Remarks:

RECORD
 Cased _____ in., _____ ft.
 Sand _____
 Gas _____
 Oil _____
 Total Depth 1135

PRODUCTION
 1st 24 hrs. Nat. _____
 1st 24 hrs. after shot _____
 Gas _____ Cu. Ft.
 Dry Hole _____
 Abandoned _____

Date OCT 7 1936
19 _____ S. J. LEWIS Scout

Map No. _____ Sec. 8 Twp. 15 R. 18WWell No. 4 Ruder

Armer et al.

Company

FIRST REPORT

Contractor

NE SW SE

SECTION PLAT

Ft. from N. Line

990 Ft. from S. Line

Ft. from E. Line

990 Ft. from W. Line

Ellis County

Location _____

Rig up _____

Drilling and Remarks:

12" @ 1135

drlg. 3275

DWDJ

RECORD

Cased _____ in., _____ ft.

Sand _____

Gas _____

Oil _____

Total Depth _____

PRODUCTION

1st 24 hrs. Nat. _____

1st 24 hrs. after shot _____

Gas _____ Cu. Ft.

*Dry Hole _____

Abandoned _____

Date

APR 13 1949

19

S. J. LEWIS

Scout

Map No. K74 Sec. 8 Twp. 15 R. 18WWell No. 4 Ruder

Armer et al.

Company

COMPLETE

Contractor

NE SW SE

SECTION PLAT

Ft. from N. Line

990 Ft. from S. Line

Ft. from E. Line

990 Ft. from W. Line

Ellis County

Location _____

Rig up _____

Drilling and Remarks:

QX3574

5" QX3574

Pump 100 oil 100

28-6

RECORD

Cased _____ in., _____ ft.

Sand _____

Gas _____

Oil _____

Total Depth 3526

PRODUCTION

1st 24 hrs. Nat. _____

1st 24 hrs. after shot _____

Gas _____ Cu. Ft.

Dry Hole _____

Abandoned _____

Date

MAY 25 1949

19

S. J. LEWIS

Scout

ELLIS

Map No. **KANSAS**

Sec. 8 Twp. 15 R. 18-W

Well No. **4-Ruder** Farm

~~Ormer et al~~
~~Gibson et al~~

Company


O. W. D. D

Ft. from N. Line

990 Ft. from S. Line

Ft. from E. Line

990 Ft. from W. Line

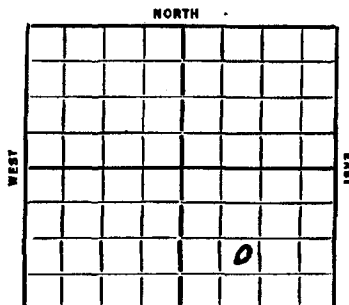

Elev. 2010

SOUTH

Date	Elev 2010'	REPORT
1936		
4/15		Rig
4/23		Rigging up.
4/30		12" @ 1135'
5/7		S.D.
5/14		-- 5/21-- 5/28-- 6/4-- 6/11-- 6/18--
6/25		-- 7/2-- 7/9-- 7/16-- 7/23-- 7/30--
8/6		-- 8/13-- 8/20-- 8/27-- 9/3-- 9/10--
9/18		-- 9/24-- 10/1--
10/7		/36-Dry and abandoned at 1135'.
		ABANDONED
1949		O. W. D. D
4/13		12" @ 1135'
		Drilg. 3275'
4/20		Arb. 3574@76'
		TD 3576'
		5" @ 3574'
4/27		"
5/4		"
5/10		"
5/18		"

1949
5/25

TD 3576'
Arb. 3574'
5" @ 3574'
Pump 100 Oil Pot
280 Gr.
Comp

COMPLETED

KANSAS

Form 51-5M-4-86-Palace

Ellis

Section 8 Township 15 Range 18-W

Well Number 4-Ruder

Company Armer et al
Gibson et al

O. W. D. D

