


KANSAS

Map No. 74 Sec. 8 Twp. 15 R. 18WWell No. 2 SwissGulf Companyi Contractor

SECTION PLAT

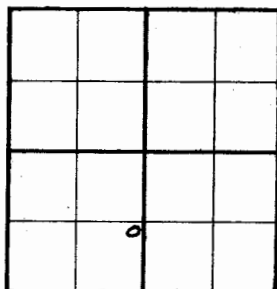

_____ Ft. from N. Line

990 Ft. from S. Line320 Ft. from E. Line

_____ Ft. from W. Line

FIRST REPORT

Location _____

RECORD

Cased _____ in., _____ ft.

Rig up _____

Sand _____

Drilling and Remarks:

Gas _____

Oil _____

Total Depth _____

PRODUCTION

1st 24 hrs. Nat. _____

1st 24 hrs. after shot _____

Gas _____ Cu. Ft.

Dry Hole _____

Abandoned _____

Date

MAY 20 1936

19

S. J. LEWIS


Scout

KANSAS

Map No. 74 Sec. 8 Twp. 15 R. 18WWell No. 2 SwissGulf Company

_____ Contractor

SECTION PLAT

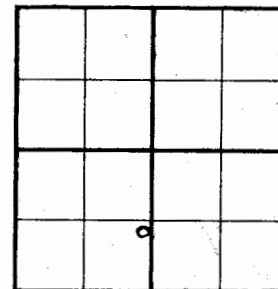

_____ Ft. from N. Line

990 Ft. from S. Line320 Ft. from E. Line

_____ Ft. from W. Line

COMPLETED

Location _____

RECORD

Cased _____ in., _____ ft.

Rig up _____

Sand _____

Drilling and Remarks:

Gas _____

Oil _____

Total Depth 3560 1/2

PRODUCTION

1st 24 hrs. Nat. _____

1st 24 hrs. after shot _____

Gas _____ Cu. Ft.

Dry Hole _____

Abandoned _____

Date

AUG 19 1936

19

S. J. LEWIS

Scout

Ellis

Map No. **KANSAS** Sec. **8** Twp. **15** R. **18W**Well No. **#2 Swires** Farm**Gulf**


Company

Ft. from N. Line

990' Ft. from S. Line**330'** Ft. from E. Line

Ft. from W. Line

Elev. 1989

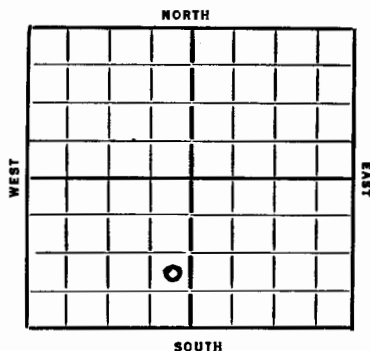

REPORT

Date
1936**5/20 Moving in.****5/28 Building rig.****6/4 Rigging up.****6/11 10" @ 1100'. Waiting on cement.****6/18 Topeka 2843'. Drlg. 2920'.****6/25 Drlg. 3239'.****7/2 Oswald 3251'. T.D. 3328'. Clean out****7/9 140 bbls of oil in 24 hours. Will
drill deeper.****7/16 Drlg. 3385'.****7/23 Drlg. 3469'.****7/30 3531' Under ream 5".****8/6 Siliceous 3554'. 5" @ 3555'. C.O.****8/13 T.D. 3560½'. 2900' oil in 10½ hrs.****No test.****8/19/36-Sil. 3554'.****T.D. 3560½'.****1000 gallons of acid.****1160 bbls of oil potential.****COMPLETED**

KANSAS

Form 51-5M-4-86-Palace

Ellis

Section **8** Township **15** Range **18W**Well Number **#2 Swires**Company **Gulf**