

Kansas

Wildcat

Map No. _____ Sec. 8 Twp. 15 R. 18W


Well No. 1 A. Ruder

M. B. Armer Company

Contractor

NE NE NE

SECTION PLAT

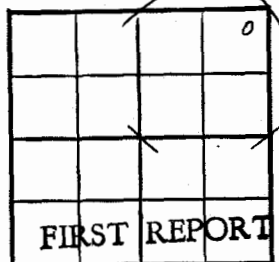

380 Ft. from N. Line

Ft. from S. Line

340 Ft. from E. Line

Ft. from W. Line

Ellis Anv. Lien DHM

Location

RECORD

Cased in, ft.

Sand

Gas

Oil

Total Depth

PRODUCTION

1st 24 hrs. Nat.

1st 24 hrs. after shot

Gas Cu. Ft.

Dry Hole

Abandoned

Date

JUN 7 1950 19

J. E. TYRA Scout

Kansas

Wildcat

Map No. _____ Sec. 8 Twp. 15 R. 18W

Well No. 1 A. Ruder

M. B. Armer Company

Contractor

NE NE NE

E1. 1997
SECTION PLAT

380 Ft. from N. Line

Ft. from S. Line

340 Ft. from E. Line

Ft. from W. Line

Ellis County

Location

RECORD

Cased in, ft.

Sand

Gas

Oil

Total Depth 3675

PRODUCTION

1st 24 hrs. Nat.

1st 24 hrs. after shot

Gas Cu. Ft.

Dry Hole

Abandoned

D & A

Date

JUL 5 1950 19

J. E. TYRA Scout

KANSAS

Ellis

Sec. 8 Twp. 15 R. 18-W

Well No. #1 A. Ruder Farm

M. B. Armen Company

Contractor

Wildcat

380 Ft. from N. Line


Ft. from S. Line

340 Ft. from E. Line

Ft. from W. Line

NE NE NE

Any. Lion DHM

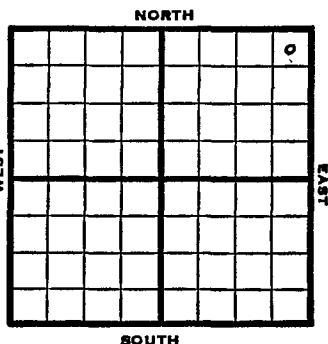

1950 Elev 1997 REPORT

6/7 Location

7/5 Anhy 1160 Heeb 3253
Lans 3290 Cnng 3595
Arb 3646
TD 3675
D&A

ABANDONED

Ellis

KANSAS

Section 8 Township 15 Range 18W

Well No. #1 A. Ruder

Company M. B. Armer

