

Map No. 74 Sec. 8 Twp. 15 R. 18W

Well No. 2-Ruder

A. H. Gibson et al Company

Contractor

SECTION PLAT

		0	

Ft. from N. Line

990 Ft. from S. Line

Ft. from E. Line

330 Ft. from W. Line

Location.....

Rig up.....

Drilling and Remarks:

cellar

RECORD

Cased.....in.,ft.

Sand.....

Gas.....

Oil.....

Total Depth.....

PRODUCTION

1st 24 hrs. Nat.....

1st 24 hrs. after shot.....

Gas.....Cu. Ft.

Dry Hole.....

Abandoned.....

Date

1-19-36 192

ORVAL MANNSCHECK

Scout

Map No. 74 Sec. 8 Twp. 15 R. 18W

Well No. 2-Ruder

Gibson et al Company

Contractor

CORRECTION

SECTION PLAT

		0	

Ft. from N. Line

330 Ft. from S. Line

Ft. from E. Line

990 Ft. from W. Line

Location.....

Rig up.....

Drilling and Remarks:

incorrectly reported
as being in
NW SW SE

RECORD

Cased.....in.,ft.

Sand.....

Gas.....

Oil.....

Total Depth.....

PRODUCTION

1st 24 hrs. Nat.....

1st 24 hrs. after shot.....

Gas.....Cu. Ft.

Dry Hole.....

Abandoned.....

Date

FEB 28 1936 192

H. H. H.

Scout


Map No. 74 Sec. 8 Twp. 15 R. 18W

Well No. 2 Ruder

Gibson et al Company

Contractor

SECTION PLAT

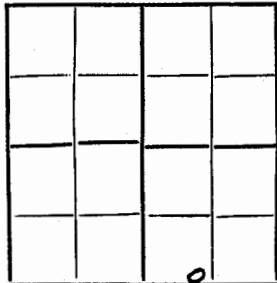

Ft. from N. Line

330 Ft. from S. Line

Ft. from E. Line

990 Ft. from W. Line

COMPLETED

Location

Rig up

Drilling and Remarks:

Oswald 3277 -

Pay 3305-16

Potential

866 Natural

RECORD

Cased in. ft.

Sand

Gas

Oil

Total Depth 3331

PRODUCTION

1st 24 hrs. Nat.

1st 24 hrs. after shot

Gas Cu. Ft.

Dry Hole

Abandoned

Date

4/8/36

192

S. J. LEWIS


Scout

Map No. KANSAS Sec. 8 Twp. 15 R. 18W

Well No. 2- Ruder Farm

A. H. Gibson et al Company

NORTH

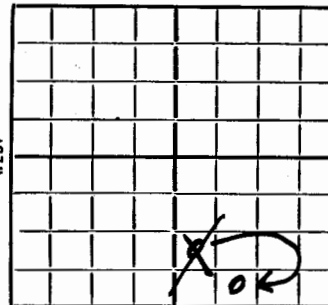

Ft. from N. Line

330
990

Ft. from S. Line

Ft. from E. Line

990
330

Ft. from W. Line

Elev. 2009

REPORT

1936

2/19 Oswald

2/28 Rotary Rig

3/6 —

3/13 20"-62- WOC

3/20 Drlg. 1362

3/27 Drlg. 3072'

4/2 T. Osw. 3277' 8"- 3280' Pay 3305'

4/8 to 16' T.D. 850' oil Bailing.

Oswald 3277

Pay 3305-16

T.D. 3331

pot 866 Natural

COMPLETED

