



Ellis KANSAS

SEC.	TWP.	R.
9	15	18 W

WELL NO. # 1 Dinges FARM

COMPANY Frontier Oil

CONTRACTOR Schaffer Drlg.  
Ruder Pool


330 Ft. from N. Line

Ft. from S. Line

330 Ft. from E. Line

Ft. from W. Line

NE NE NE

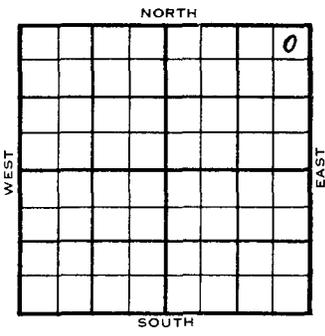

CSO - DHM

	ELEVATION	REPORT
1954	2029'	
5/19	Cellar & Pits	
5/26	8" @ 185 Drlg. 1700'	
6/2	Anhy 1210 Heeb 3275 Lans 3326 Drlg. 3385	
6/9	DST 3411-27, 1 hr, 8' M 900# Arb. 3625 DST 3622-36, 1 hr, 120' HOCM 1025# 5" @ 3626 TD 3636'	
7/14	Spud 5-22-54 Oil well TD 3636 8" @ 185 Anhy 1210 Heeb 3275 Lans. 3326 DST 3411-27 open 1 hr rec 8' mud 900# Arb. 3625 DST 3622-36 open 1 hr rec 120' HOCM 1025# 5" @ 3626 TD 3636 CO to 3628 B/1 BOPH 7 hr. 250 A S/3 BOPH 10 hr. Comp. 53 BOPD	

COMPLETED

DX-78

DX 78-1

Ellis

KANSAS

Section 9 Township 15 Range 18W

Well No. #1 Dinges

Company Frontier Oil

