

Map No. _____ Sec. 9 Twp. 15 R. 18W

Well No. 1 Madden


Jones & Shelborne Company

FIRST REPORT Contractor

NE NW SW

SECTION PLAT

330 Ft. from N. Line
____ Ft. from S. Line
____ Ft. from E. Line
990 Ft. from W. Line

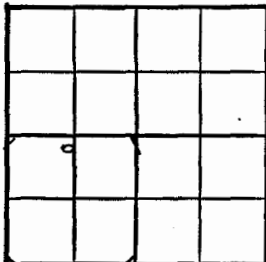

Ellis County

Location X

Rig up _____

Drilling and Remarks:

RECORD

Cased _____ in., _____ ft.
Sand _____
Gas _____
Oil _____
Total Depth _____

PRODUCTION

1st 24 hrs. Nat. _____
1st 24 hrs. after shot _____
Gas _____ Cu. Ft.
Dry Hole _____
Abandoned _____

Date

SEP 24 1947 19 S. J. LEWIS Scout

Map No. 74 Sec. 9 Twp. 15 R. 18W

Well No. 1 Madden


Jones & Shelborne Company

CORRECTION Contractor

SE NW SW

SECTION PLAT

990 Ft. from N. Line
____ Ft. from S. Line
____ Ft. from E. Line
990 Ft. from W. Line

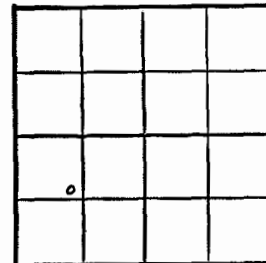

Ellis County

Location _____

Rig up _____

Drilling and Remarks:

RECORD

Cased _____ in., _____ ft.
Sand _____
Gas _____
Oil _____
Total Depth _____

PRODUCTION

1st 24 hrs. Nat. _____
1st 24 hrs. after shot _____
Gas _____ Cu. Ft.
Dry Hole _____
Abandoned _____

Date

OCT 1 1947 19 S. J. LEWIS Scout

KANSAS Ellis

Sec. 9 Twp. 15 R. 18W

1947

Well No. #1 Madden Farm

12/23

Jones & Shelborne Company

Madden

990

330 Ft. from N. Line


_____ Ft. from S. Line

_____ Ft. from E. Line

990 Ft. from W. Line

SE

NE NW SW

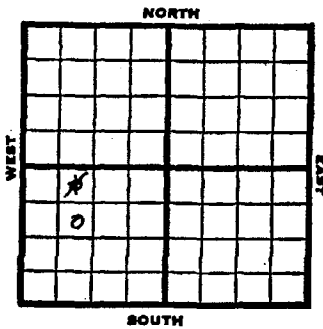

Arb. 3592'
5" @ 3592'
Lans. 3249'
Perf. Lans.
2000 acid.
Pump 100 pot
28 1/6 Gr.
TD 3595'

COMPLETED

1947	Elev. 2012' REPORT
9/24	Location
10/1	8" @ 1140' Drlg. 2447'
10/8	Lansing 3249' DST 3286-90 open 1/4 hr. Rec 700' oil Arbuckle 3592' TD 3595' 5" @ 3592' RUST
10/15	72 shots 3292-3312 - 2000 Acid 2500' oil 12 hrs.
10/22	"
10/29	"
11/5	"
11/12	"
11/19	"
11/25	"
12/3	"
12/10	"

OVER

