

Map No. _____ Sec. 9 Twp. 15 R. 18W

Well No. 3 Madden "C"


Jones & Shelborne Company

Jones & Shelborne Contractor

SW NW SW

SECTION PLAT

990 Ft. from N. Line
_____ Ft. from S. Line
_____ Ft. from E. Line
330 Ft. from W. Line

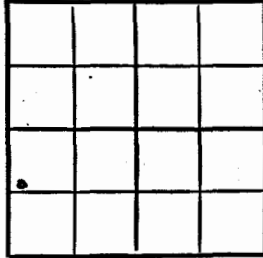

Ellis County

Location X

Rig up _____

Drilling and Remarks:

RECORD

Cased _____ in., _____ ft.
Sand _____
Gas _____
Oil _____
Total Depth _____

PRODUCTION

1st 24 hrs. Nat. _____
1st 24 hrs. after shot _____
Gas _____ Cu. Ft.
Dry Hole _____
Abandoned _____

Date

SEP 14 1948

19

S. J. LEWIS

Scout

Map No. _____ Sec. 9 Twp. 15 R. 18W

Well No. 3 Madden "C"


Jones & Shelborne Company

COMPLETE Contractor

SW NW SW

E. 1990
SECTION PLAT

990 Ft. from N. Line
_____ Ft. from S. Line
_____ Ft. from E. Line
330 Ft. from W. Line

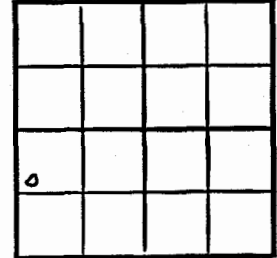

Ellis County

Location _____

Rig up _____

Drilling and Remarks:

Per 3558

5" casing

Pump 122 oil

2728

RECORD

Cased _____ in., _____ ft.
Sand _____
Gas _____
Oil _____
Total Depth 2562

PRODUCTION

1st 24 hrs. Nat. _____
1st 24 hrs. after shot _____
Gas _____ Cu. Ft.
Dry Hole _____
Abandoned _____

Date

OCT 25 1948

19

S. J. LEWIS


Scout

KANSAS Ellis

Sec. 9 Twp. 15 R. 18W

Well No. #3 Madden "C" Farm
Jones & Shelborne Company
Madden Pool (Jones & Shelborne Cont.)

990' Ft. from N. Line
Ft. from S. Line
Ft. from E. Line
330' Ft. from W. Line

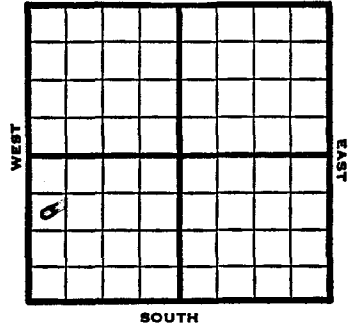

SW NW SW

1949	Elev. 1990'	REPORT
9/14		Location
9/21	8" @ 1173'	Drlg. 2250'
9/28		Lansing 3243' BKC 3495' Arb. 3555' TD 3562' 5" @ 3561'
10/5		"
10/12		Swb 4 1/4 bbls oil PH 24 hrs.
10/19		"
10/20		Arb 3555' 5" @ 3566' Pump 122 oil Pot. Gr. 27° TD 3562'
		COMPLETED

KANSAS Ellis

Section 9 Township 15S Range 18W

Well No. #3 Madden "C"
Company Jones & Shelborne

