

Ellis KANSAS ✓

Sec. 10 Twp. 15 R. 18 W

Well No. # 4 Wassinger Farm

Francis Oil & Gas Company

Armer Contractor


330 Ft. from N. Line

Ft. from S. Line

Ft. from E. Line

990 Ft. from W. Line

NE NW SE

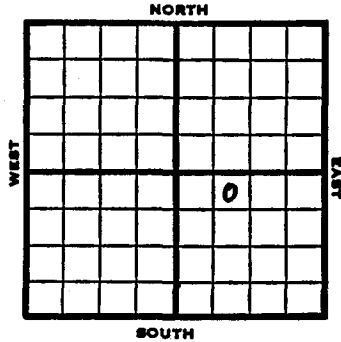


Ellis KANSAS

Section 10 Township 15 Range 18 W

Well No. # 4 Wassinger

Company Francis Oil & Gas

NORTH

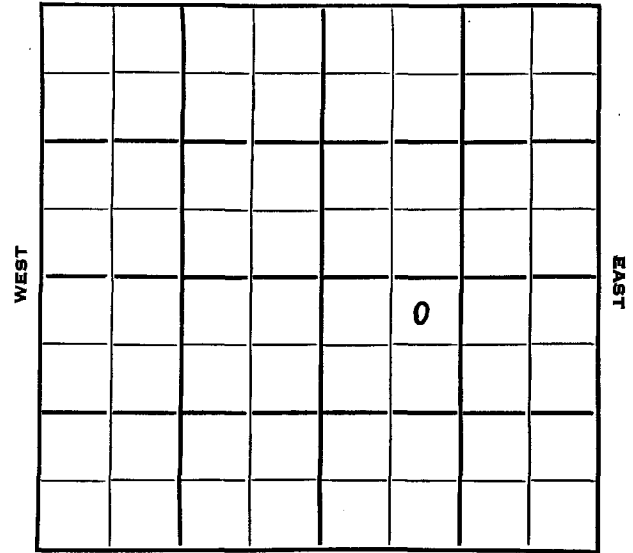

SOUTH

1953 Elev. 2013' REPORT

8/26 Location

9/2 "

9/9 MI

9/16 Anhy 1180
8" @ 1186
Drlg. 2269'

9/23 Heeb 3260 Tor 3282 Lans 3308
B KC 3553 Arb 3599
DST 3600-3603, 1 hr, 900' free oil
1000# 15" RTD 3603 5" @ 3600

9/30 CO 3603
S. 11 boph

10/7 NR

10/14 "

10/21 Oil well TD 3603' Anhy 1180'
8" @ 1186 Heeb 3260' Tor. 3282'
Lans. 3308 B KC 3533' Arb. 3599
DST 3600-03 open 1 hr rec 900' free
oil, 1000# TD 3603' 5" @ 3600
CO to 3603 S/11 BOPH
Comp. 210 BOPD 3 BW

COMPLETED