

County Ellis State Kansas

Sec. 10 (Blk. Twp.) 15 (Sur. Rge.) 18W Map No. _____

Operator Francois O. & G. Co.

Well No. 2 Farm Nassinger

Elev. _____ Location C N/2 SW SE

990 Ft. From S Line SE
660 Ft. From W Line Quarter

lst. Report JUL 14 1953

Completion _____

Remarks _____

Vendor - Contr.

Spudding Date 7-6-53

Drlg. Data

8" @ 1176 w/550 Ash 1171 Drlg. 2837

J. G. McGEHEE

County Ellis State Kansas

Sec. 10 (Blk. Twp.) 15 (Sur. Rge.) 18W Map No.

Operator Francis Oil & Gas

Well No. 2 Farm Wassinger

Elev. 2001 Location C N L SW SE

990 Ft. From S Line SE

660 Ft. From W Line Quarter

1st. Report

Completion AUG 26 1953

Remarks

Veeder - Contr.

Spudding Date 7-6-53

Drilg. Data Oil well TD 3578

8" @ 1176 Anhy1171 Heeb. 3241

Tor. 3262 Lans. 3294 Marm. 3512

Arb. 3570 TD 3574 5" @ 3572

CO to 3574 S/ 40 bo 6 hr. DD 3578

S/ 15 $\frac{1}{2}$ boph Comp. 471 bopd

J. G. McGEHEE

ELLIS KANSAS
15 B. 18W

Sec. 10 Twp. 15 R. 18W

Well No. #2 Wassinger Farm

Francis O & G Co. _____ Company

Veeder _____ **Contractor**


Ft. from N. Line

990 _____ Ft. from S. Line

Ft. from E. Line

660 _____ Ft. from W. Line

C N/2 SW SE

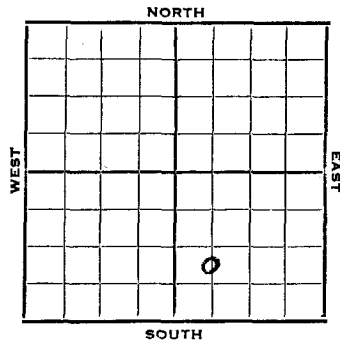

1953	Elev. 2001'	REPORT
------	-------------	--------

7/14 Spud 7-6-53
8" @ 1176 w/550
Anh 1171
Drlg. 2837'

7/22 Drlg.

7/29 Heeb 3241, Tor 3262, Lans 3294, Marm
3512, Arb 3570
RTD 3574
5* @ 3572

8/5 CO 3574 S/40 BO 6 hrs. DD 3578 TD
S/15½ BOPH.

~~XXXXXXXXXXXXXXXXXXXX~~
~~XXXXXXXXXXXXXXXXXXXX~~ 011 #011 ID 9918
~~XXXXXXXXXXXXXX~~

8712 NR

8/26 Spud 7-6-53 Oil well TD 3578
8" @ 1176 Anhy 1171 Heeb 3512'
Arb. 3570 TD 3574 5" @ 3572
CO to 3574 S/40 BO 6 hr. DD 3578
S/15 $\frac{1}{2}$ BOPH
Comp. 471 BOPD

COMPLETED

FORM 51

Ellis KANSAS

Section 10 Township 15 Range 18 W

Well No. # 2 Wassinger

Company Francis O & G Co.

