



O.W.W.O. Ellis KANSAS

SEC.	TWP.	R.
11	15	18W

WELL NO. #1 John "A" FARM

COMPANY Phillips Petr.

CONTRACTOR Stag Drlg.

Leikaa Pool


330 Ft. from N. Line

330 Ft. from S. Line

330 Ft. from E. Line

Ft. from W. Line

SE SE SE

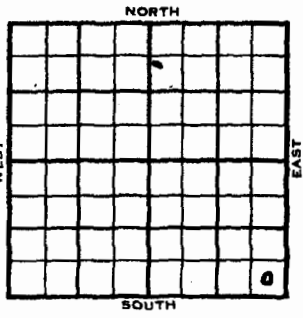

1955  
9/28

O.W.W.O.

Old Info: TD 3601'. 5" @ 3593  
Phy Pot. 181 BOPD, no wtr. - Arbuckle.  
NEW INFORMATION:  
PB 3360' 28/3325-32 Swab 60 BO,  
no wtr. 6 hrs; 1500 A; Flo 11 1/2 BO  
8 min. Swab 28' BO 1 hr, no wtr.  
Pump 99 BO, no wtr. Grav 41.6  
Phy. pot. 493 BOPD, no wtr.  
Grav 42.4 from L-KC 3325-32  
TD 3601' PBD 3360' - COMPLETE  
L. KC 3303' Arb. 3593'

FIRST REPORT

COMPLETED

	ELEVATION	REPORT
1953	2019'	
9/9	RUR	
9/16	10" @ 1170' w/800 sks	
	Anhy 1166'	
	Drlg. 2330'	
9/23	Heeb 3255 Tor 3277 Lans 3303	
	Drlg. 3520'	
9/30	B KC 3536, Marm 3547, Cong 3586, Arb 3593	
	TD 3595'	
	Schl	
	7" @ 3593'	
	DD 3601	
	FU 200' oil & hr, S/ 7 bo 2 hrs.	
	S/ 33 BO 6 hrs.	
10/7	NR	
10/14	Spud 9-9-53	
	Oil Well	
	TD 3601'	
	10" @ 1170	
	Anhy 1166', Heeb 3255, Tor 3277',	
	Lans 3303, B KC 3536', Marm 3547',	
	Cong 3586', Arb. 3593',	
	TD 3595'	
	7" @ 3593, DD 3601, FU 200' oil	
	1 hrs., S/7 bo 2 hrs, S/33 bo 6 hrs.	
	Comp. 181 bopd	COMPLETED

OVER

O.W.W.O.

FORM 513 REV. SUNRAY


County Ellis Elev. 2019 DF  
 Sec. 11 Twp. 15 Rge. 18 W  
 Company Phillips Pet. Co.  
 Farm Name John "A" No. 1

TOPS	DEPTH	LOG	DATUM	Loc. in Sec.
Anh.				SE SE SE
TP.				
H.				
Tr.				
Dg.				
Bl.				
L. <u>3303</u>				
K.C.				Geol.
B.K.C.				Contr.
Ce.				
C.				
M.				
M.				Pool
K.				<u>Leilow R.</u>
Mz.				
Me.				
V.				
S.				
A.				
R.	<u>3593</u>			FIRST REPORT COMPLETED
PC.				
G.				

O.W.O.

FIRST REPORT COMPLETED

FORM O.W.W.O. Ellis KANSAS  
 Section 11 Township 15 Range 18 W  
 Well No. # 1 John "A"  
 Company Phillips Pet.

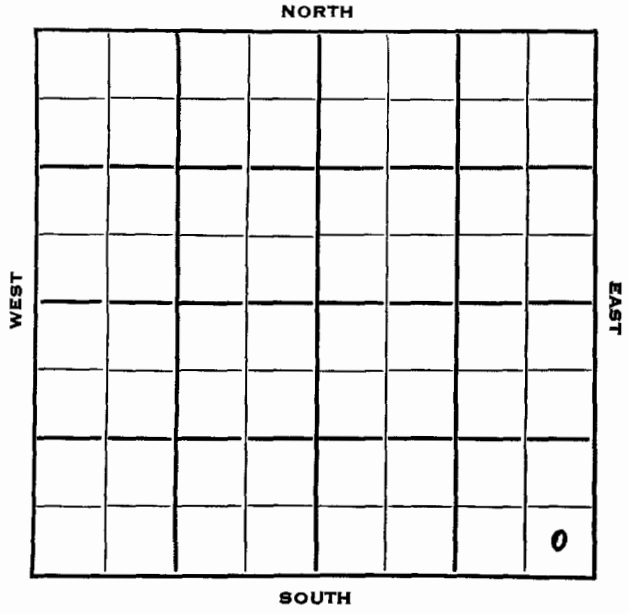

Date Comm. Old info - TD 3601; 5" 3593; SEP 28 1955  
Phy. Pot. 181 bopd no wtr. Arb.  
New info - PH 3360; 28/3325-32; sub 60  
be no wtr. 6 hrs.; 1500 A; flo 1 1/2 be  
6 min.; sub 28 be 1 hr. no wtr.; pmp 99  
be no wtr. grav. 41.6; Phy. pot. 493 bopd  
no wtr. grav. 42.4 from LMC 3325-32  
TD 3601 PSTD 3360  
Complete