


Ellis KANSAS

SEC. 11 TWP. 15 R. 18 W
 WELL NO. # 2 John "A"
 COMPANY FARM
 Phillips Pet.

CONTRACTOR
 Co. tools
 E. Leiker Pool

_____ Ft. from N. Line
 330 _____ Ft. from S. Line
 990 _____ Ft. from E. Line
 _____ Ft. from W. Line

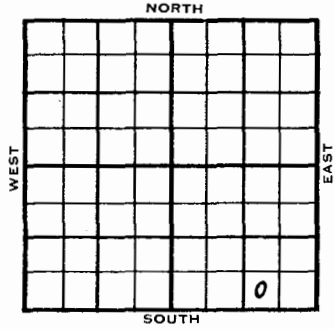

SW SE SE

1954 ELEVATION 2017' REPORT

10/27 Location
 12/22 Spud 11-7-54
 Oil Well
 TD 3625'
 Anhy 1162'
 10-3/4" @ 850'
 Top 3026' Heeb 3257' Tor 3280' Lans
 3304' BKC 3538', Arb. 3616'
 TD 3619'
 Log Tops: Lans 3310' BKC 3552'
 Marm 3559', Cong 3593' Arb. 3622'
 TD 3625'
 7" @ 3617'
 CO to 3578'
 8/ 3533-35 B/ 7 gm wtr. 500 A
 S/ 30 bo 60 bw. 3 hr. 1500 A
 S/ 62 bo 1 1/2 Wtr. 8 hr. SP 3380
 2 1/4/ 3327-33 S/ 3 1/4 bw. 10 hr. CO 3334'
 2 1/4/ 3306'-12 S/ 2 bwph 3 hr. 500 A
 S / 40 bwph 2 hr. CO 3578' S/ 16 bo 3
 hr. P/ 8 1/4 bo 15 bw. 12 hr.
 Comp 13 1/4 bopd.

COMPLETED

Ellis KANSAS

Section 11 Township 15 Range 18W
 Well No. 2 John "A"
 Company Phillips Petr.

