

O.W.W.O.

FORM 513 REV. SUNRAY

County Ellis Elev. 2020 Co.
 Sec. 11 Twp. 15 Rge. 18W
 Company Phillips Pet.
 FarmName John "A" No. 3

TOPS	DEPTH	LOG	DATUM	Loc. in Sec.
Anh.				NE SE SE
Tr.	3254			
H.				
Tr.				
Dg.				Geol.
Bl.				
L.				
K.C.	3302			
B.K.C.				Contr.
C.				
M.	3575			
Marm.	3547			
K.				Pool
Mz.				
Me.				
V.				
S.				E. Leiker
A.	3610			
R.				
PC.				
G.				No.
TD	3623			

06-26-55
 FIRST REPORT
 COMPLETE

Date Comm.
 7" @ 3622 PB 3491 perf. 3459-62
 P/4 2/3 bo 7 hr. 1500 A
 19 bo 2 hr. perf. 3324-28 P/59 bo
 5 hr. 1500 A P/84 bo 4 hr.
 00 to 3614 P/150 bo 100 bo 22 hr.
 Comp, 299 bopd 86 bo

O.W.W.O. Ellis KANSAS

SEC.	TWP.	R.
11	15	18W

WELL NO. 3 John "A" FARM

COMPANY Phillips Petr.


CONTRACTOR Co. Tools

E. Leiker Pool

_____ Ft. from N. Line
 990 _____ Ft. from S. Line

330 _____ Ft. from E. Line

_____ Ft. from W. Line

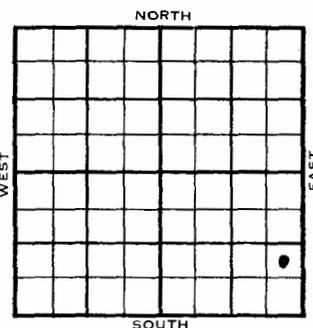

NE SE SE

1954 ELEVATION 2020' REPORT

11/17 Location
 12/29 Spud 11-24-54
 Oil Well
 TD 3623'
 Anhy 1167'
 10-3/4" @ 1177'
 Howard. 2986' Top 3025' Heeb 3254'
 Tor 3274' Lans 3302' B KC 3532
 Marm 3547' Cong 3575' Arb. 3610'
 TD 3623'
 7" @ 3622'
 CO to 3614'
 20/ 3608'-13' S/66 3/4 bo 11 hr.
 Comp 171 bopd.

COMPLETED

1955 O.W.W.O.
 10/26 7" @ 3622 PB 3491 Perf 3459-62
 P/4-2/3 BO 7 hr. 1500 A. 19 BO 2 hr.
 Perf 3324-28 P/59 BO 5 hr. 1500 A
 P/84 BO 4 hr. CO to 3614 P/150 BO
 100 BW 22 hr. Comp. 299 BOPD 86 BW
 TD 3623'
 H. 3254', KC 3302', C. 3575',
 Marm 3547', A. 3610'
 FIRST REPORT
 COMPLETED

DX-78

O.W.W.O.
DX 78-1 Ellis

KANSAS

Section 11 Township 15 Range 18W

Well No. #3 John "A"

Company Phillips Pet.

