



Ellis

KANSAS


SEC.	TWP.	R.
11	15	18W

WELL NO. #4 John "A" FARM

COMPANY Phillips Pet.

CONTRACTOR Co. Tools.

E. Leiker Pool NORTH

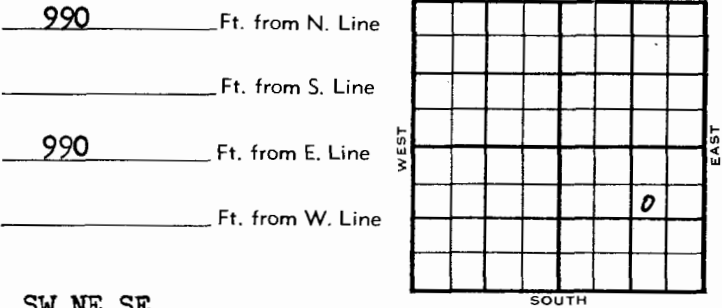

1954 ELEVATION 2021' REPORT

12/22 Location  
 1955 Spud 12-26-54  
 1/12 D & A  
 TD 3695'  
 Anhy 1166'  
 9" @ 1174'  
 Howard 2986' Top 3035' Heeb 3263'  
 Tor 3283' Lans 3310'  
 DST 3333'-40' opn 1 hr, rec 1365' s.w.  
 1080#  
 DST 3400'-09' opn 1 hr, rec 20' Mud  
 990#  
 B KC 3542' Marm 3558' Cong 3621'  
 Arb. 3662'  
 TD 3695'  
 D & A

ABANDONED

DX-78

DX 78-1

Ellis

KANSAS

Section 11 Township 15 Range 18W

Well No. #4 John "A"

Company Phillips Pet.

