

County Ellis Elev. 18W
 Sec. 11 Twp. 15 Rge. 18W
 Company Carl Todd Drlg.
 Farm Name Leiker No. 1

TOPS	DEPTH	LOG	DATUM	Loc. in Sec.
Ank.				NE NE NW
Tr.				
H.				
Tr.				
Dg.				
Bl.				
L.				Geol.
K.C.				Contr.
B.K.C.				
Ce.				
C.				
M.				Pool
K.				Leiker Ext.
Mz.				
Me.				
V.				
S.				
A.				
R.				
Pe.				
G.				
TD				

FIRST REPORT
JUL 11 '56

Date Comm.

Cellar & pits

County Ellis Elev. 2023
 Sec. 11 Twp. 15 Rge. 18W
 Company Carl Todd Drlg.
 Farm Name Leiker No. 1

TOPS	DEPTH	LOG	DATUM	Loc. in Sec.
Ank.	1200			NE NE NW
Tr.				
H.	3284			
Tr.	3304			
Dg.				
Bl.				
L.	3332			Geol.
K.C.				Contr.
B.K.C.				
Ce.	3592			
C.				
M.				Pool
K.				Leiker Ext.
Mz.				
Me.				
V.				
S.				
A.				
R.				
Pe.				
G.				
TD	3655			

ABANDONED
JUL 25 1956

Date Comm.

Cellar & pits JUL 18 '56 7-13-56

8 3/8 @ 200 / 175 P 2310
JUL 25 '56

DGA

Ellis

KANSAS

SEC. 11	TWP. 15	R. 18W
------------	------------	-----------

WELL NO. #1 Leiker FARM

COMPANY
Carl Todd Drlg.
CONTRACTOR

Leiker Ext.


FT. FROM N. LINE

FT. FROM S. LINE

FT. FROM E. LINE

FT. FROM W. LINE

NE NE NW

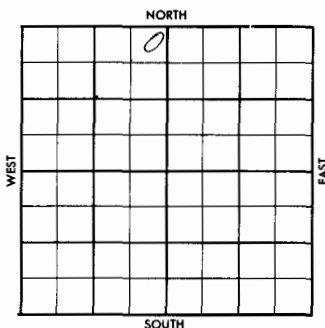

1956	ELEVATION 2023'	REPORT
------	--------------------	--------

7-11 Cellar & pits

7-25 Comm. 7-13-56
8 5/8" @ 200 w/175

D & A

Anh. 1200'; H. 3284'; Tr. 3304';

L. 3332'; C. 3592'

TD 3655'

ABANDONED

DX 78-1 Ellis

KANSAS

Section 11 Township 15 Range 18W

Well No. #1 Leiker

Company Carl Todd Drlg

