

# KANSAS

Map No. 74 Sec. 12 Twp. 15 R. 18W.

Well No. 1 Leikes

Sinas Oil & Gas Company

Contractor

### SECTION PLAT

		o	

330 Ft. from N. Line  
 \_\_\_\_\_ Ft. from S. Line  
 \_\_\_\_\_ Ft. from E. Line  
330 Ft. from W. Line

FIRST REPORT

Location  \_\_\_\_\_  
 Rig up \_\_\_\_\_  
 Drilling and Remarks: \_\_\_\_\_

**RECORD**  
 Cased \_\_\_\_\_ in., \_\_\_\_\_ ft.  
 Sand \_\_\_\_\_  
 Gas \_\_\_\_\_  
 Oil \_\_\_\_\_  
 Total Depth \_\_\_\_\_

**PRODUCTION**  
 1st 24 hrs. Nat. \_\_\_\_\_  
 1st 24 hrs. after shot \_\_\_\_\_  
 Gas \_\_\_\_\_ Cu. Ft.  
 Dry Hole \_\_\_\_\_  
 Abandoned \_\_\_\_\_

Date JUL 29 1936 19 S. J. LEWIS Scout

# KANSAS

Map No. 74 Sec. 12 Twp. 15 R. 18W.

Well No. 1 Leikes

Sinas Oil & Gas Company

Contractor

### SECTION PLAT

		o	

330 Ft. from N. Line  
 \_\_\_\_\_ Ft. from S. Line  
 \_\_\_\_\_ Ft. from E. Line  
330 Ft. from W. Line

ABANDONED

Location \_\_\_\_\_  
 Rig up \_\_\_\_\_  
 Drilling and Remarks: Oil 3585  
HPW 3613  
DYH


**RECORD**  
 Cased \_\_\_\_\_ in., \_\_\_\_\_ ft.  
 Sand \_\_\_\_\_  
 Gas \_\_\_\_\_  
 Oil \_\_\_\_\_  
 Total Depth 3616

**PRODUCTION**  
 1st 24 hrs. Nat. \_\_\_\_\_  
 1st 24 hrs. after shot \_\_\_\_\_  
 Gas \_\_\_\_\_ Cu. Ft.  
 Dry Hole \_\_\_\_\_  
 Abandoned \_\_\_\_\_

Date OCT 14 1936 19 S. J. LEWIS Scout

Map No. **KANSAS** Sec. **12** Twp. **15** R. **18W**

Well No. **#1 Leiker** Farm  
**Simar Oil et al** Company

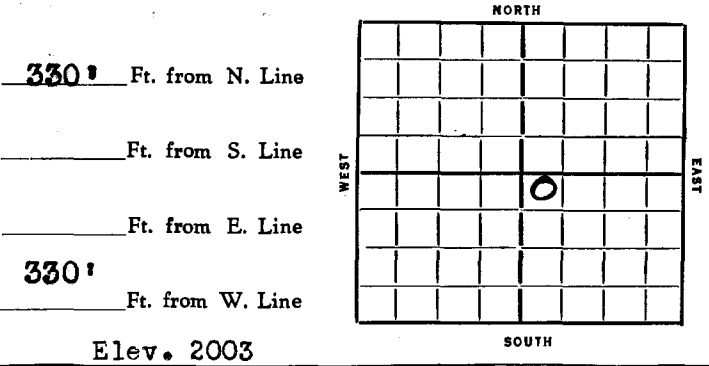

1986	REPORT
7/29	Location
8/6	Rig.
8/13	Spud 280'.
8/20	Drlg. 410'.
8/27	12" @ 795'. Drilling.
9/3	Anhydrate 1150-10" @ 1160'. Dlg.
9/10	Drlg. 2175'.
9/18	8" @ 2630'. S.D.
9/24	Drlg. 2980'.
10/1	Oswald 3296'. 6" @ 3326'. Drlg. <del>3327'</del> 3327'.
10/8	Hole full of water 3375'. 6" @ 3408'. Show oil 3408-12'. Fishing 3475'.
10/14/36	Sil. 3585'. Hole full of water 3613'. T.D. 3616'. Dry and abandoned.
	<b>ABANDONED</b>

Section **12** Township **15** Range **18-W**

Well Number **#1-Leiker**

Company **Simar Oil et al**

