

Ellis KANSAS ✓

Sec. 12 Twp. 15 R. 18 W

Well No. # 2 Brock Farm

Don Pratt Company

Mast Drlg. Contractor


Ft. from N. Line

990 Ft. from S. Line

Ft. from E. Line

990 Ft. from W. Line

NE SW SW

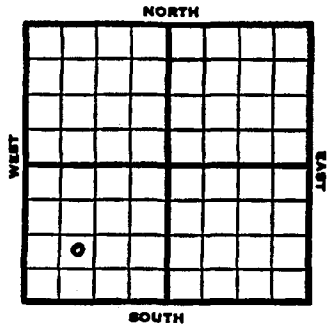

1953
 11/18 • Spud 9-1-53
 Oil Well
 TD 3608'
 Anhy 1170'
 8" @ 1183'
 Heeb 3248', Lans 3298'
 DST 3435-63, opn 1 hr., rec. 95'
 hocm, 110' vhocm, 10' free oil,
 1250#
 B KC 3526', Cong 3566', Arb. 3588',
 TD 3608'
 5" @ 3607'
 CO to 3608', 500A
 S/8 boph, 12/3590-94
 Comp. 182 BOPD

COMPLETED

1953	Elev. 2016'	REPORT
9/2		MIM
9/9		Anhy 1170' 8" @ 1183' Drlg 2385'
9/16		Heeb 3248, Lans 3298 DST 3435-63, 1 hr., 95' HOCM, 110' VHOCM, 10' free oil, 1250# B KC 3526, Cong 3566, Arb 3588 RTD 3608 5" @ 3607
9/23		CO 3608' Log 500 A S/8 BOPH POP
9/30		N.R.
10/7		"
10/14		"
10/28		"
11/4		"
11/11		"

OVER

Section 12 Township 15 Range 18W

Well No. #2 Brock

Company Don Pratt

