


O.W.W.O. Ellis KANSAS
 SEC. 12 TWP. 15 R. 18W ✓
 WELL NO. 3 Brock FARM
 COMPANY Don Pratt
 CONTRACTOR

Glen Nye
 E. Leiker Pool
 _____ Ft. from N. Line
 990 _____ Ft. from S. Line
 _____ Ft. from E. Line
 330 _____ Ft. from W. Line
 NW SW SW

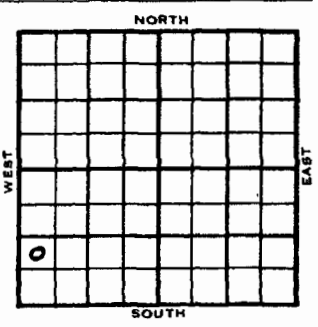

1953	ELEVATION	REPORT
	2018'	
11/4	Spud 10-28-53 8" @ 165'	
11/11	Anhy 1175' Drig. 2 170' Heeb 3254', Lans 3302', Arb. 3604' RTD 3638' Schl 5" @ 3637'	
11/18	WOCT	
12/9	12/3606-08 S/4 BOPH POP	
12/16	NR	
1954		
1/6	NR	
1/13	NR	
1/20	Spud 10-28-53 Oil well TD 3638 8" @ 165' Anhy 1175' Heeb 3254' Lans. 3302 Arb. 3604 TD 3638 5" @ 3637 12/3606-08 S/4 BOPH Comp. 85 BOPD	

COMPLETED

OVER

DX-78

1955
5/25

O.W.W.O.

Oil well TD 3638' KC 3302 Arb. 3604
 OTD 3638 5" @ 3637 SP 3350
 24/3323-30 500 A F/17 BOPH
 Comp. 3000 BOPD
 Dual Comp. KC & Arb.

FIRST REPORT
 COMPLETED

O.W.W.O.

County Ellis State Kansas
 Sec. 12 (Blk. Twp.) 15 (Sur. Rge.) 18W Map No.
 Operator D. Pratt
 Well No. 3 Farm Brock
 Elev. 2018 Location NW SW SW

990Ft. From SLine SW
 330Ft. From WLine Quarter
 Ist. Report MAY 2 5 1955
 Completion O.W.W.O.
 Remarks O.W.W.O.
 Spudding Date _____

Drig. Data Oil well TD 3638
KC 3302 Arb. 3604 OTD 3638
5" @ 3637 SP 3350 24/ 3323-30
500 A F/ 17 boph Comp. 3000 bopd
Dual Comp. KC & Arb.

FIRST REPORT COMPLETE

Ellis

FORM 5 O.W.W.O.

Section 12 Township 15 Range 18W
 Well No. #3 Brock
 Company Don Pratt

