

Orig. Data

Location

J. G. McGEHEE

Drig. Data	Oil well	TD 3616
8" @ 1138	Top. 2966	Heeb. 3249
Tor. 3259	DST 3259-87	open $\frac{1}{4}$ hr.
Rec. 10' mud	716#	Lans. 3297
DST 3316-28	open 1 hr.	F/ oil in 35 min.
3300' oil	1180#	B KC 3528 Cong. 3575
TD 3616	5" @ 3616	CO to 3600
23/ 3321-29	1000 A	F/ 190 bo 3 hr.
Comp. BHB	3000 bopd	

FABEN GILSTRAP

Ellis KANSAS

SEC. 14 TWP. 15 R. 18W

WELL NO.

4 Dechant FARM

Woodriver Ref.

CONTRACTOR

Keifer & Krause


330 Ft. from N. Line

Ft. from S. Line

990 Ft. from E. Line

Ft. from W. Line

NW NE NE

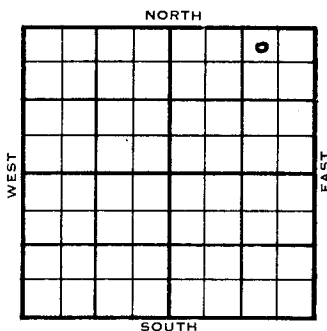

1954 ELEVATION 2012' REPORT

7/7 Location
7/21 8" @ 1138'
Drlg. 3105'
9/8 Spud 7-11-54 Oil well TD 3616
8" @ 1138 Top. 2966 Heeb 3249
Tor. 3259
DST 3259-87 open 1/4 hr. rec 10' mud
716# Lams 3297
DST 3316-28 open 1 hr F/oil in 35 mi
3300' oil 1180# B KC 3528
Cong. 3575 TD 3616 5" @ 3616
CO to 3600 23/3321-29 1000 A
F/190 BO 3 hr.
Comp. BHB 3000 BOPD
COMPLETED

DX-78

Ellis KANSAS

DX 78-1

Section 14 Township 15 Range 18W

Well No. 4 Dechant

Company Woodriver Ref

