

County Ellis State Kansas

Sec. 14 (Bk.) 15 (Sur.) 18W Map No.
(Twp.) (Rge.)

Operator Woodriver Oil & Ref.

Well No. 3 Farm Dochant

Elev. _____ Location NE SE NE

FIRST REPORT

990 Ft. From # Line NE

330 Ft. From # Line Quarter

OCT 28 1953

Ist. Report _____

Completion _____

Remarks _____

Fleming & Woodman - Contr.

Spudding Date 10-25-53

Drlg. Data	E. Leiker Pool
drlg. 1051	

J. G. McGEHEE

County Ellis State Kansas

Sec. 14 (Blk.) 15 (Sur.) 18W Map No.
 (Twp.) (Rge.)

Operator Woodriver Oil & Ref.

Well No. 3 Farm Dechant

Elev. 2005 Location NE SE NE

										990 Ft. From S Line NE
										330 Ft. From E Line Quarter
										1st. Report
										Completion NOV 11 1953
										Remarks E. Licker Pool
										Fleming & Woodman - Contr.
										Spudding Date 10-25-53

ABANDONED

Drig. Data	D & A	TD 3610
8" @ 1168	Anhy 1160	Top. 2960
Heeb. 3246	KC 3295	DST 3298-3344
open 2 hr.	Rec. 580'	sw & SO & GCM
1000#	DST 3435-74	open 1 hr. Rec.
150' wtr.	DST 3598-3602	rec. 30' sw
Arb. 3609	TD 3610	

D & A

J. G. McGEHEE

Ellis

KANSAS

Ellis KANSAS

FORM 51

SEC. 14	TWP. 15	R. 18W
---------	---------	--------

Section 14 Township 15 Range 18W

WELL NO. #3 Dechant FARM

Well No. 3 Dechant

COMPANY Woodriver Oil & Ref.

Company Woodriver Oil & Ref.

CONTRACTOR Fleming & Woodman

E. Leiker Pool



Ft. from N. Line

990 Ft. from S. Line

330 Ft. from E. Line

Ft. from W. Line

NE SE NE

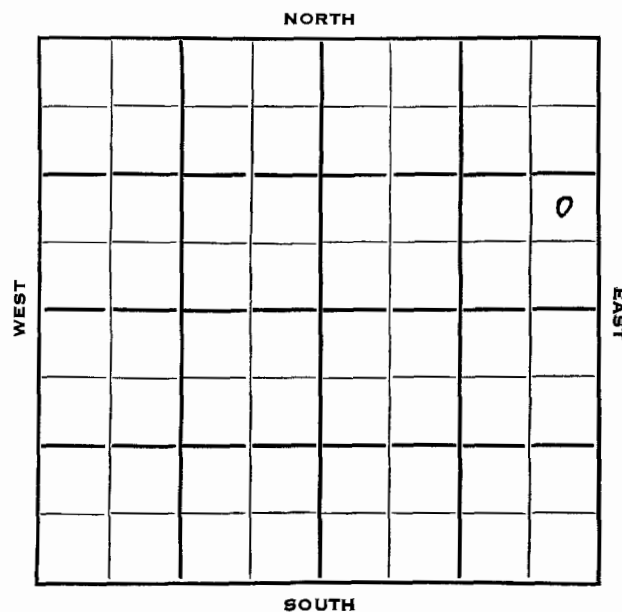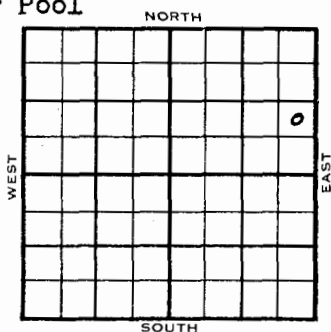

	ELEVATION	REPORT
1953	2005'	
10/28	spud 10-25-53	Drlg 1031'
11/4	8" @ 1168'	Anhy 1160'
		Drlg. 3069'
11/11	Spud 10-25-53	
	D & A	
	TD 3610'	
	8" @ 1168'	
	Anhy 1160', Top 2960', Heeb 3246'	
	HC 3295'	
	DST 3298'-3344' opn 2 hr, rec 580' sw	
	& SO & GCM 1000#.	
	DST 3435'-74' opn 1 hr, rec 150' wtr,	
	DST 3598'-3602' rec 30' sw Arb 3609'	
	TD 3610'	
	D & A	
		ABANDONED