


SEC. 14 TWP. 15 R. 18W

WELL NO. 2 Graf FARM

COMPANY Frontier Oil

CONTRACTOR Kiefer-Krause
Leiker Pool

 Ft. from N. Line
990 Ft. from S. Line
330 Ft. from E. Line
 Ft. from W. Line

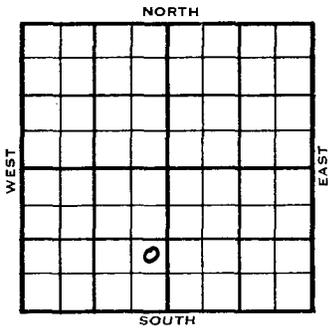

NE SE SW

	ELEVATION	REPORT
<u>1954</u>	<u>1973</u>	
<u>7/28</u>		<u>Spdg 7-26-54</u>
<u>9/1</u>		<u>Spud 7-26-54 Oil well TD 3570</u> <u>8" @ 1139 Heeb 3208 Lans 3257</u> <u>B KC 3478 Arb. 3553</u> <u>DST 3558-70 open 1 hr rec 97' 0 &</u> <u>GCM, 60' muddy gassy oil 1000#</u> <u>TD 3570 5" @ 3557 CO to 3570</u> <u>S/1 BO 10 GWPH 500 A S/18 BOPH</u> <u>Comp. 251 BOPD 23% wtr.</u>
		COMPLETED

DX 78-1

Section 14 Township 15 Range 18W

Well No. 2 Graf

Company Frontier Oil

